

ALICO COMMERCE CENTER

BUILDING B 89,834 SF

UNOCCUPIED SHELL

DREW CIRCLE

FORT MYERS LEE COUNTY, FLORIDA

PERMIT NO. COM2004-02119
 PLAN CHECK 10-12-04
 BID SET 10-22-04

ART CONCEPTS, Inc.
 AA 26000601
 2051 TRADE CENTER WAY
 NAPLES, FLORIDA
 PHONE 239-593-4633
 FAX 239-592-0077

ART CONCEPTS, INC. HAS BEEN LICENSED BY THE FLORIDA BOARD OF PROFESSIONAL ENGINEERS AND ARCHITECTS TO PREPARE ARCHITECTURAL AND ENGINEERING PLANS AND SPECIFICATIONS FOR THE PROJECTS DESCRIBED HEREIN. THESE PLANS AND SPECIFICATIONS ARE PREPARED BY ART CONCEPTS, INC. AND ARE NOT TO BE USED FOR ANY OTHER PROJECTS WITHOUT THE WRITTEN PERMISSION OF ART CONCEPTS, INC. CONTRACTORS SHALL VERIFY AND BE RESPONSIBLE FOR ALL DIMENSIONS AND CONDITIONS OF THE JOB AND SHALL BE RESPONSIBLE FOR ANY CHANGES TO THESE PLANS AND SPECIFICATIONS. ALL CONSTRUCTION SHALL BE IN ACCORDANCE WITH THE APPLICABLE FLORIDA AND LOCAL CODES.

THE OWNER OR CONTRACTOR SHALL BE TOTALLY RESPONSIBLE FOR THE CONSTRUCTION OF THIS PROJECT AND SHALL FOLLOW ALL LOCAL BUILDING CODES, ORDINANCES, REGULATIONS, ORDINANCES, OR REQUIREMENTS OF ANY CODES AND ORDINANCES BY THE CONTRACTOR'S DOCUMENTS FROM COMMENCEMENT OF CONSTRUCTION.

THE ARCHITECT'S SERVICES ARE LIMITED TO THE DESIGN AND PREPARATION OF THE PLANS AND SPECIFICATIONS AND ARE NOT TO BE USED FOR ANY OTHER PROJECTS WITHOUT THE WRITTEN PERMISSION OF THE ARCHITECT. CONTRACTORS SHALL VERIFY AND BE RESPONSIBLE FOR ALL DIMENSIONS AND CONDITIONS OF THE JOB AND SHALL BE RESPONSIBLE FOR ANY CHANGES TO THESE PLANS AND SPECIFICATIONS. ALL CONSTRUCTION SHALL BE IN ACCORDANCE WITH THE APPLICABLE FLORIDA AND LOCAL CODES.

JACK GILLILAND ARCHITECT
 AR 0009984

ARCHITECTURAL FIRM
 ART CONCEPTS, INC.
 2051 TRADE CENTER WAY
 NAPLES, FLORIDA 34109
 239-593-4366
 DALE A WEISL

STRUCTURAL ENGINEER
 J.C. KOSINSKI ENGINEERING
 2312 A-KLINE AVE
 FORT MYERS, FLORIDA
 239-210-2902
 JOE KOSINSKI

LANDSCAPE ARCHITECT
 ARCHITECTURAL LAND DESIGN
 2780 S. HORSESHOE DRIVE STE 5
 NAPLES, FLORIDA
 239-430-1661
 CHRISTAN ANDREA

SYMBOLS

- CONCRETE MASONRY WALL
- INTERIOR WALL FRAMING
- INDICATES WINDOW TYPE SEE SHEET A-3.1
- INDICATES PATIO DOORS SEE SHEET A-3.2
- DOOR TYPE PER SHEET A-3.2 INDIVIDUAL DOOR NUMBER
- INDICATES WINDOW/DOOR FRAME ELEVATION SEE SHEETS A-3.1 AND A-3.2
- INDICATES MASONRY CONTROL JOINT SEE SHEET A-6.8
- INDICATES STUCCO CONTROL JOINT W/ "VEE" SCREED TRIM SEE SHEET A-6.8
- SECTION AND/OR DETAIL MARKER
 DETAIL NUMBER
 SHEET NUMBER

BUILDING CODE ANALYSIS

HANDICAP ACCESSIBILITY	YES	BUILDING CODE:	FLORIDA BUILDING CODE 2001									
THRESHOLD INSPECTIONS	NO	FIRE CODE:	NFPA 101 LIFE SAFETY CODE - 2000									
ENERGY CALCS	NO	MECHANICAL CODE:	FLORIDA BUILDING CODE , MECHANICAL 2001									
DISTANCE OF EXIT	178'-0"	PLUMBING CODE:	FLORIDA BUILDING CODE , PLUMBING 2001									
WIND LOAD CRITERIA:		ELECTRICAL CODE:	NFPA 70 - NEC 1999									
A. BASIC WIND SPEED: = 130 MPH		ACCESSIBILITY CODE:	FLORIDA BUILDING CODE , FACBC 2001									
B. WIND IMPORTANCE FACTOR: 1		ENERGY CODE	FLORIDA BUILDING CODE , ENERGY EFF 2001									
C. WIND EXPOSURE CATEGORY: C		BUILDING & LAND INFORMATION										
D. INTERNAL PRESSURE COEFFICIENT:		FLOOD ELEVATION	AE-9									
<input checked="" type="checkbox"/> 0.18 FOR ENCLOSED <input type="checkbox"/> 0.55 FOR PARTIALLY ENCLOSED		ZONING	INDUSTRIAL									
E. COMPONENTS & CLADDING:		TABLE 500 BUILDING LIMITATIONS										
ALL SIDING, ROOF COMPONENTS & OTHER BLDG COMPONENTS SHALL BE FASTENED PER FBC 2001, CHAPTER 15 CONFORMING TO LOADS INDICATED IN SECTION 1606.3. REFER TO STRUCTURAL DRAWINGS AND SPECIFICATIONS FOR QUANTIFIED LOAD/ PRESSURE VALVES.		BUILDING TYPE:	TYPE IV UNPROTECTED - FULLY SPRINKLERED ESFR									
ZONE 1 27.5 P.S.F. ZONE 3 58.7 P.S.F. ZONE 5 40.7 P.S.F. ZONE 2 58.7 P.S.F. ZONE 4 33.0 P.S.F.		OCCUPANCY	GROUP F FACTORY WAREHOUSE									
		BUILDING HEIGHT:	<table border="1"> <tr> <th></th> <th>REQUIRED</th> <th>PROVIDED</th> </tr> <tr> <td>55' MAX REQUIRED</td> <td>55' MAX REQUIRED</td> <td>35'-0" AFF</td> </tr> <tr> <td>4 STORIES</td> <td>4 STORIES</td> <td>1 STORY</td> </tr> </table>		REQUIRED	PROVIDED	55' MAX REQUIRED	55' MAX REQUIRED	35'-0" AFF	4 STORIES	4 STORIES	1 STORY
	REQUIRED	PROVIDED										
55' MAX REQUIRED	55' MAX REQUIRED	35'-0" AFF										
4 STORIES	4 STORIES	1 STORY										
		BUILDING AREA:	<table border="1"> <tr> <th></th> <th>REQUIRED</th> <th>PROVIDED</th> </tr> <tr> <td>63,000 SF</td> <td>63,000 SF</td> <td>89,834 SF</td> </tr> </table> GROUP F-TYPE IV -REQUIRED 63,000 SF PROVIDED 89,834 SF PROVIDE WITH 503.3 =98,150 SF		REQUIRED	PROVIDED	63,000 SF	63,000 SF	89,834 SF			
	REQUIRED	PROVIDED										
63,000 SF	63,000 SF	89,834 SF										

INTENT AND SCOPE OF WORK

- THE INTENT OF THE CONTRACT DOCUMENTS IS TO PRESENT A COMPLETE SET OF DOCUMENTS FOR FACILITIES TO PRODUCE A COMPLETE AND FINISHED PROJECT WITHIN THE SCOPE AS GENERALLY SHOWN IN THE DRAWINGS AND SPECIFICATIONS. HOWEVER, THE ARCHITECT ACKNOWLEDGES THAT SPECIFIC PARTS MAY NOT BE INCLUDED, AND CONTRACTOR AGREES TO ACCEPT ANY NECESSARY ADDITIONAL INFORMATION AND INCLUDE AS AN INTEGRAL PART OF THE CONTRACT DOCUMENTS WITHOUT ANY ADDITIONAL COST.
- THE CONTRACTOR IS FURTHER CAUTIONED TO VERIFY ANY EXISTING CONDITIONS WHICH MAY BE BELOW GROUND OR A PART OF THE EXISTING STRUCTURE WHICH WILL INTERFERE WITH THE CONSTRUCTION AS INDICATED ON THE DRAWINGS AND DOCUMENTS. NO ADDITIONAL COMPENSATION WILL BE APPROVED BY THE OWNER DUE TO FIELD CONDITIONS WHICH ARE NOT NOTED ON THE DRAWINGS BUT WHICH COULD HAVE BEEN OBSERVED OR DETERMINED BY SITE VISITATION AND THE REQUIREMENTS OF VERIFICATION CONTAINED AND INHERENT IN THIS PARAGRAPH.
- THE CONTRACTOR SHALL REPLACE ALL DAMAGED MATERIAL AND EQUIPMENT WITH THOSE OF LIKE QUALITY SIZE AND TEXTURE, INCLUDING FINISHES ON ALL SURFACES OF THE FACILITY WALL NEW PRODUCTS SO AS TO PRESENT A FINISHED FACILITY TO THE OWNER.
- THE CONTRACTOR SHALL BE RESPONSIBLE FOR SECURITY AND LOSSES DURING CONSTRUCTION.

SHEET INDEX

SHEET	DESCRIPTION	SHEET	DESCRIPTION
ARCHITECTURAL			
A-1.0	COVER SHEET		
A-1.1	BUILDING B PARTIAL FLOOR PLAN AA		
A-1.2	BUILDING B PARTIAL FLOOR PLAN BB		
A-1.3	BUILDING B PARTIAL ROOF PLAN AA		
A-1.4	BUILDING B PARTIAL ROOF PLAN BB		
A-1.4	BUILDING B PARTIAL ROOF PLAN BB		
A-3.1	DOOR & WINDOW SCHEDULE		
A-4.2	BUILDING B PARTIAL ELEVATION BB		
A-4.3	BUILDING B SIDE ELEVATION		
A-5.1	BUILDING SECTIONS		
A-6.1	STOREFRONT ELEVATIONS & DETAILS		
A-6.2	WALL SECTIONS		
A-6.3	WALL SECTIONS		
A-6.4	WALL SECTIONS		
STRUCTURAL			
S-0.1	GENERAL NOTES / NOTES		
S-1.1	FOUNDATION PLAN PARTIAL A-A		
S-1.2	FOUNDATION PLAN PARTIAL B-B		
S-2.1	ROOF FRAMING PLAN PARTIAL A-A		
S-2.2	ROOF FRAMING PLAN PARTIAL B-B		
S-3.1	STRUCTURAL NOTES & SPECIFICATIONS		
S-3.2	DETAILS		
S-3.3	DETAILS		
S-4.1	SECTIONS & DETAILS		
S-5.1	PANEL ELEVATIONS		
S-5.2	PANEL ELEVATIONS		
ELECTRICAL			
E-1.0	ELECTRICAL PLAN PARTIAL A-A		
E-1.1	ELECTRICAL PLAN PARTIAL B-B		
E-2.0	ENLARGED ELECTRICAL RM, RISER & NOTES		
E-2.1	FIXTURE SCHEDULE, ETC		
FIRE ALARM			
E-1.0	F.A. PLAN PARTIAL A-A		
E-1.1	F.A. PLAN PARTIAL B-B		
E-2.0	RISER & NOTES		

ALICO COMMERCE CENTER
BUILDING B
JAMES F. KNOTT REALTY GROUP
 ONE TEXAS STATION COURT
 TIMONIUM, MARYLAND

PLAN CHECK
 CORRECTIONS
 PERMIT NO. COM2004-02119
 DATE: 12/7/2004
 PROJECT#: 00/
 DRAWN BY: D.A.W.
 CHECKED BY:
 REVISIONS:

SHEET #:
A-1.0

ART CONCEPTS, INC. IS THE ARCHITECT OF RECORD FOR THIS PROJECT. THE ARCHITECT'S DESIGN AND PLANS ARE NOT TO BE REPRODUCED, CHANGED OR COPIED IN ANY FORM OR BY ANY MEANS, WITHOUT THE WRITTEN CONSENT OF THE ARCHITECT. THE ARCHITECT'S DESIGN AND PLANS ARE PROVIDED AS A SERVICE TO THE CLIENT AND ARE NOT TO BE USED FOR ANY OTHER PROJECT WITHOUT THE WRITTEN CONSENT OF THE ARCHITECT. THE ARCHITECT'S DESIGN AND PLANS ARE NOT TO BE USED FOR ANY OTHER PROJECT WITHOUT THE WRITTEN CONSENT OF THE ARCHITECT.

THE OWNER OR CONTRACTOR SHALL BE TOTALLY RESPONSIBLE FOR THE CONSTRUCTION OF THIS PROJECT AND STRICTLY FOLLOW THE LOCAL BUILDING CODES AND ORDINANCES. THE ARCHITECT SHALL NOT BE RESPONSIBLE FOR ANY CHANGES OR MODIFICATIONS TO THE CONSTRUCTION DOCUMENTS AFTER THE COMMENCEMENT OF CONSTRUCTION.


THE ARCHITECT'S RECORD SHALL NOT BE USED FOR ANY OTHER PROJECT WITHOUT THE WRITTEN CONSENT OF THE ARCHITECT. THE ARCHITECT'S DESIGN AND PLANS ARE NOT TO BE USED FOR ANY OTHER PROJECT WITHOUT THE WRITTEN CONSENT OF THE ARCHITECT.

JACK GILLILAND ARCHITECT
 AR 0009984


**ALICO COMMERCE CENTER
 BUILDING B**
 JAMES F. KNOTT REALTY GROUP
 ONE TEXAS STATION COURT
 TIMONIUM, MARYLAND

PLAN CHECK
 CORRECTIONS
 PERMIT NO. -
 DATE: 12/7/2004
 PROJECT #: 00/
 DRAWN BY: D.A.W.
 CHECKED BY:
 REVISIONS:

SHEET #
A-1.1

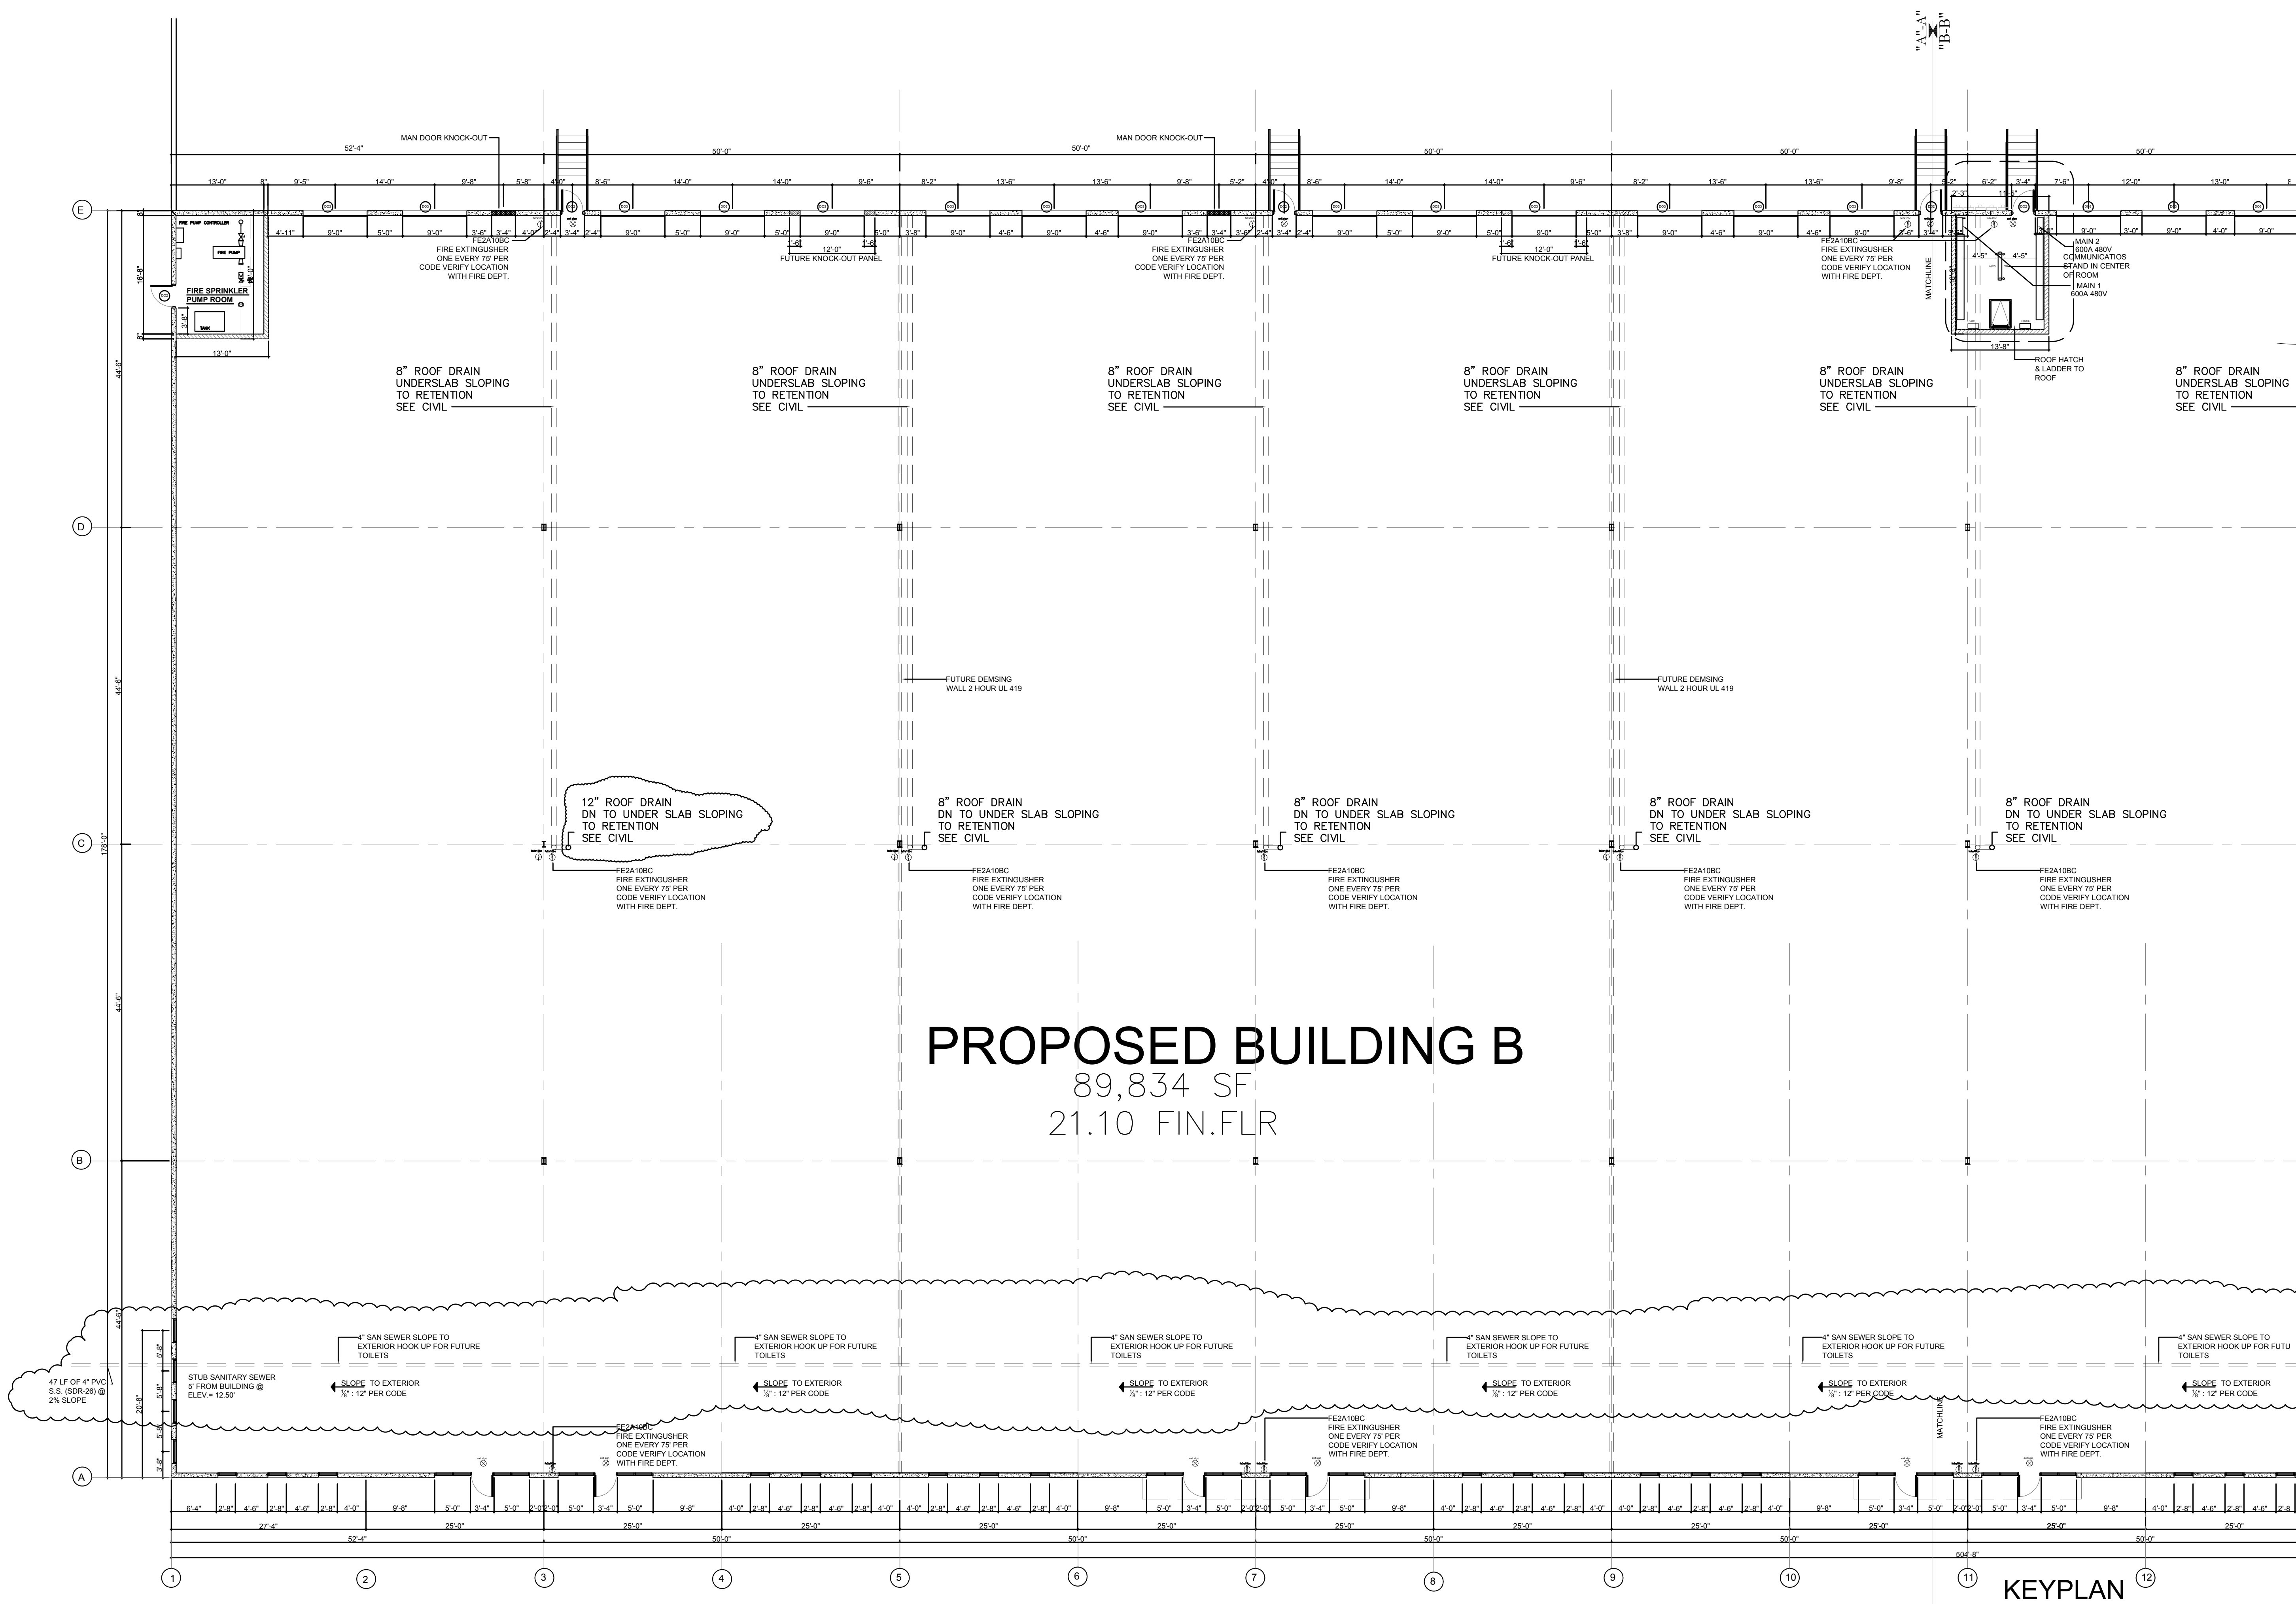






PLAN CHECK 10-12-04
 BID SET 10-22-04

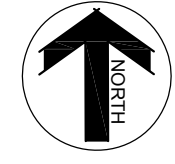

PARTIAL FLOOR PLAN "A-A"

SCALE: 3/32"=1'-0"

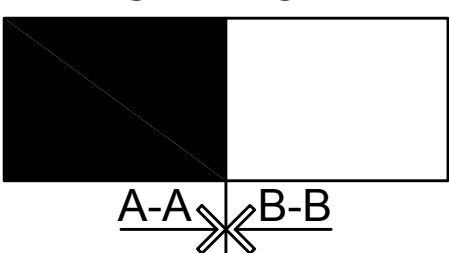


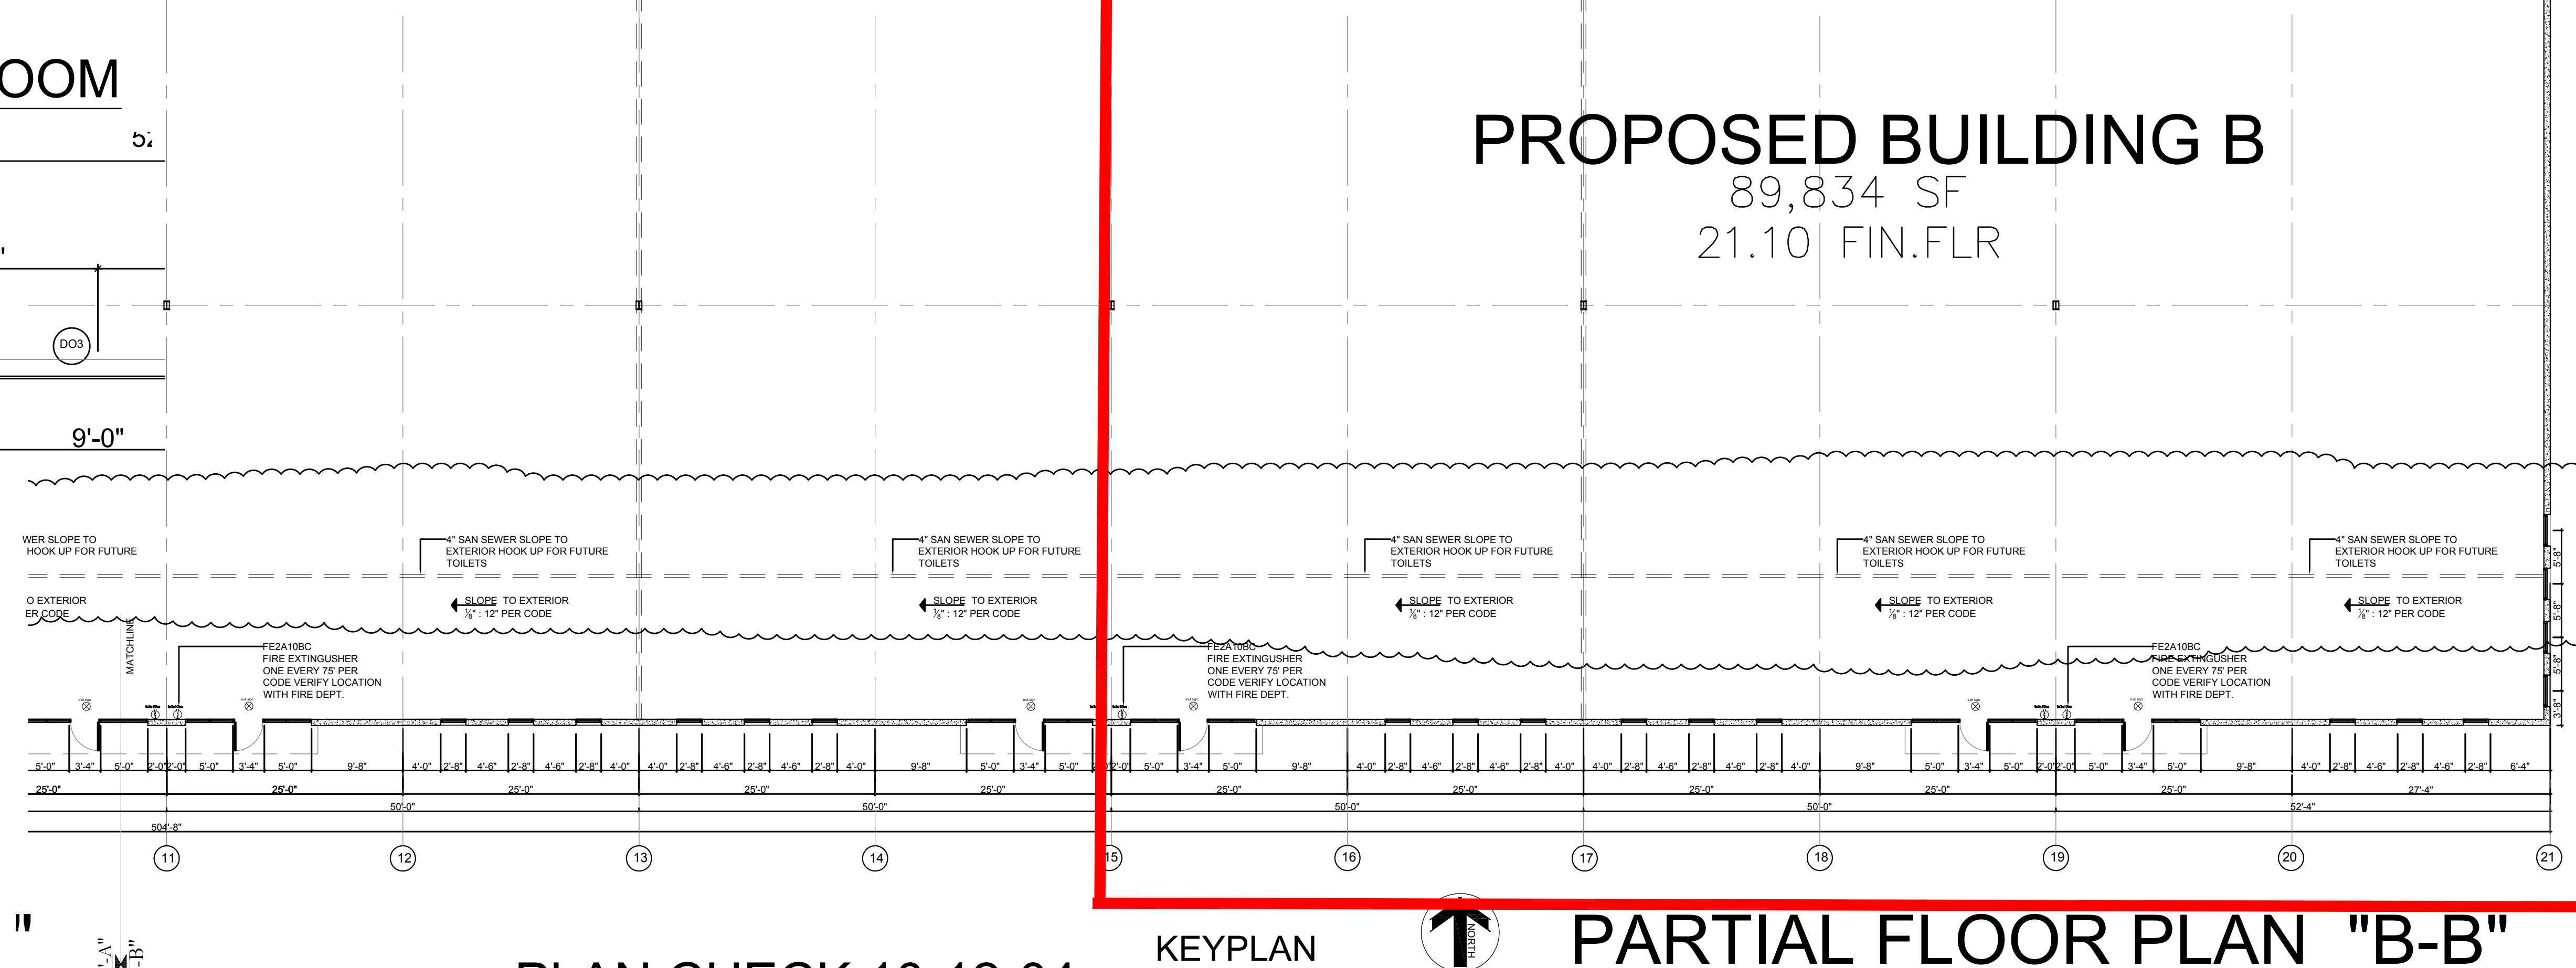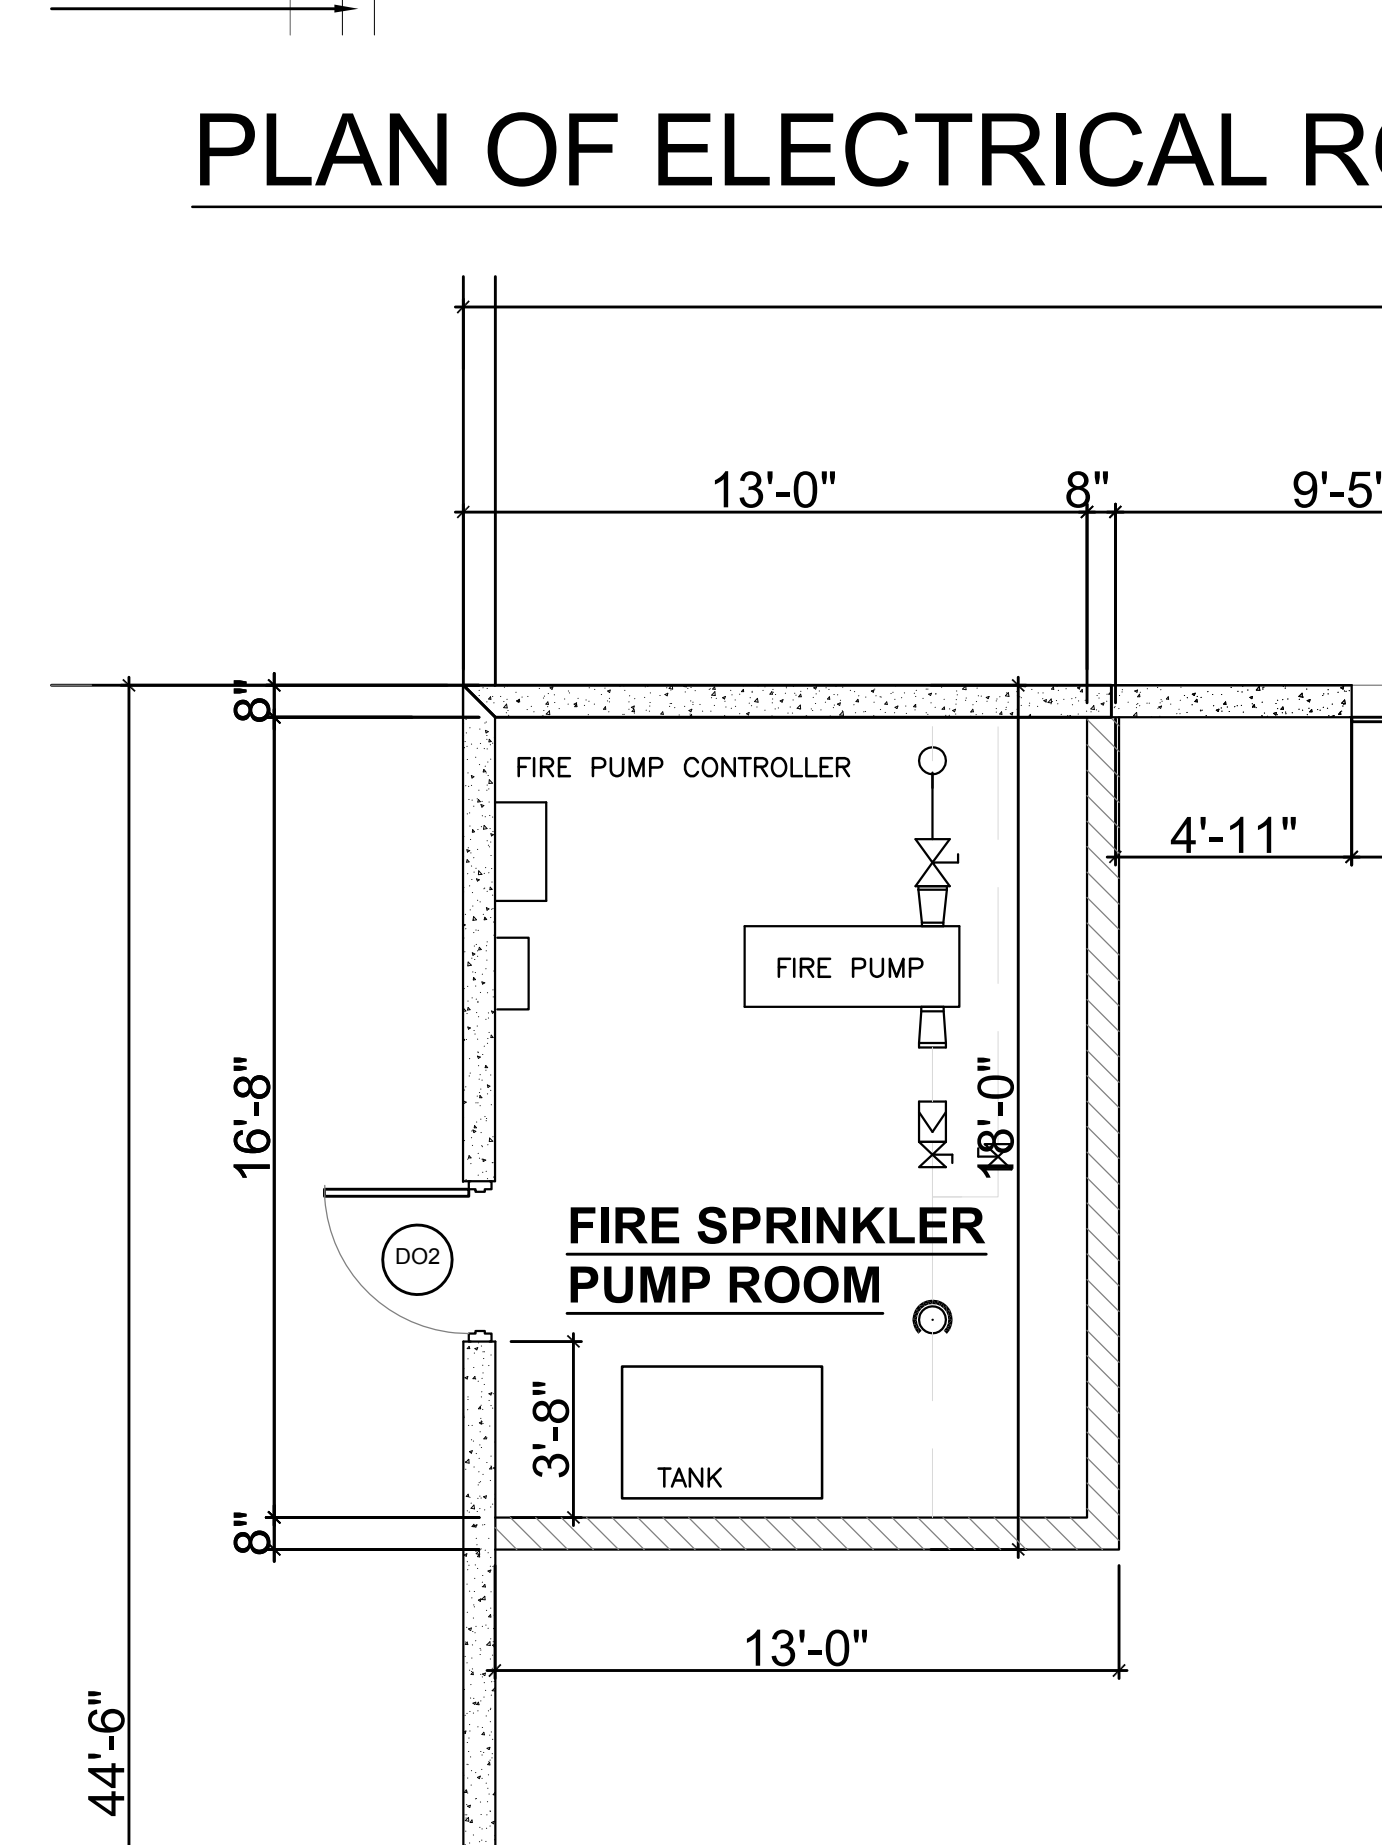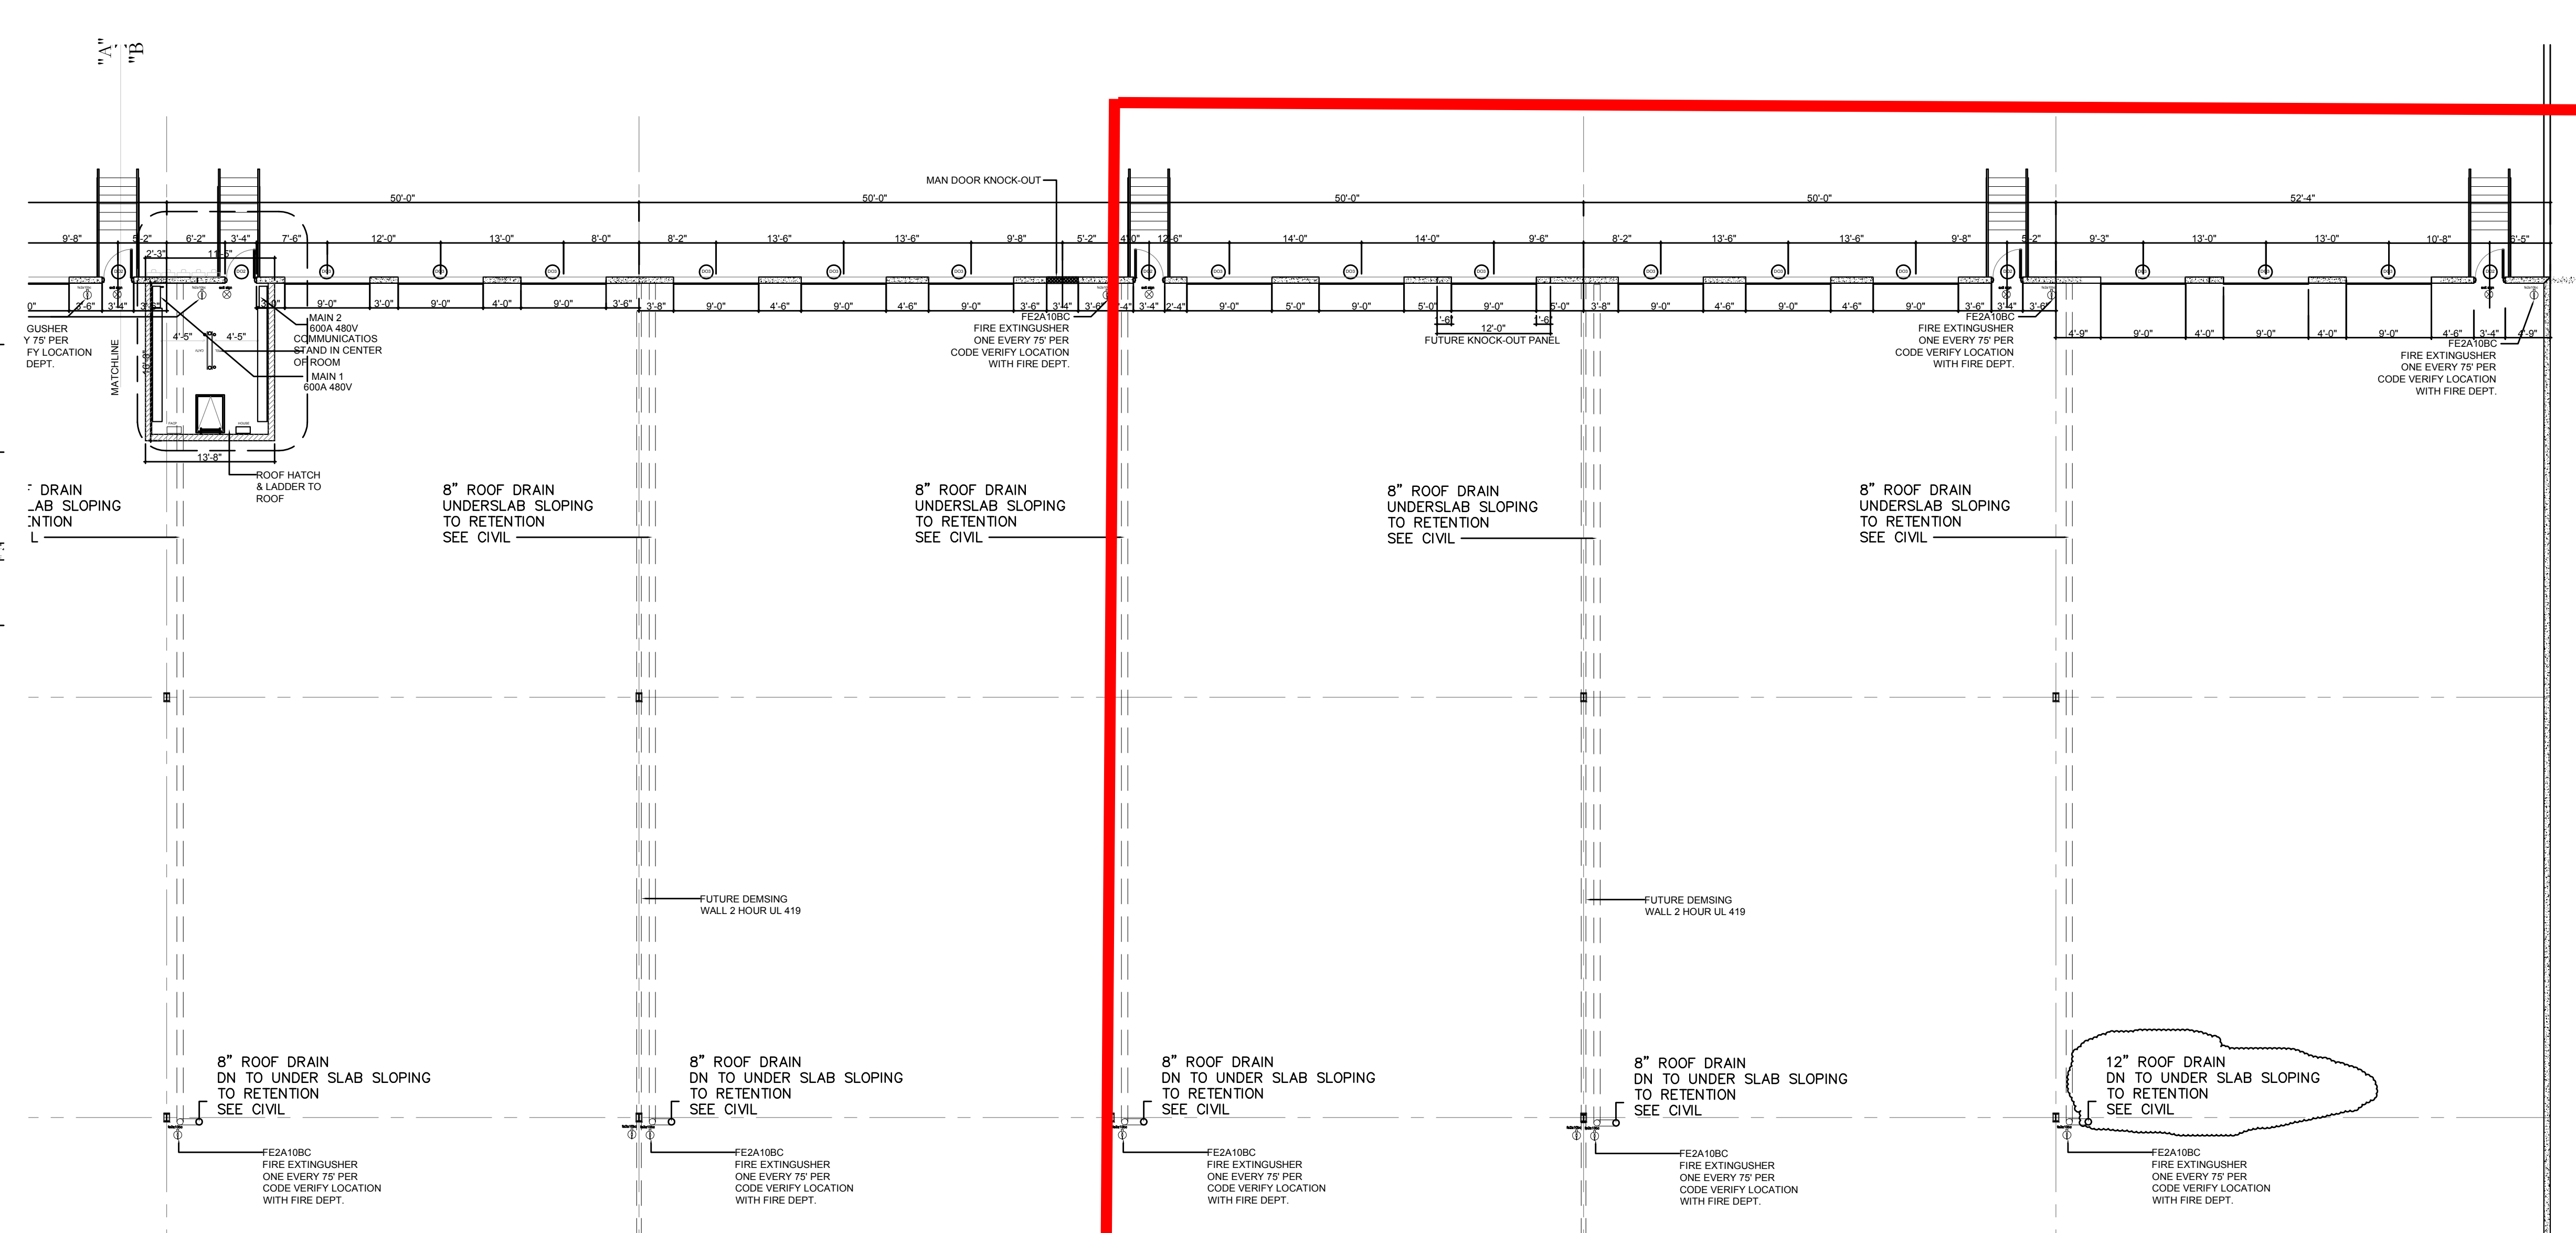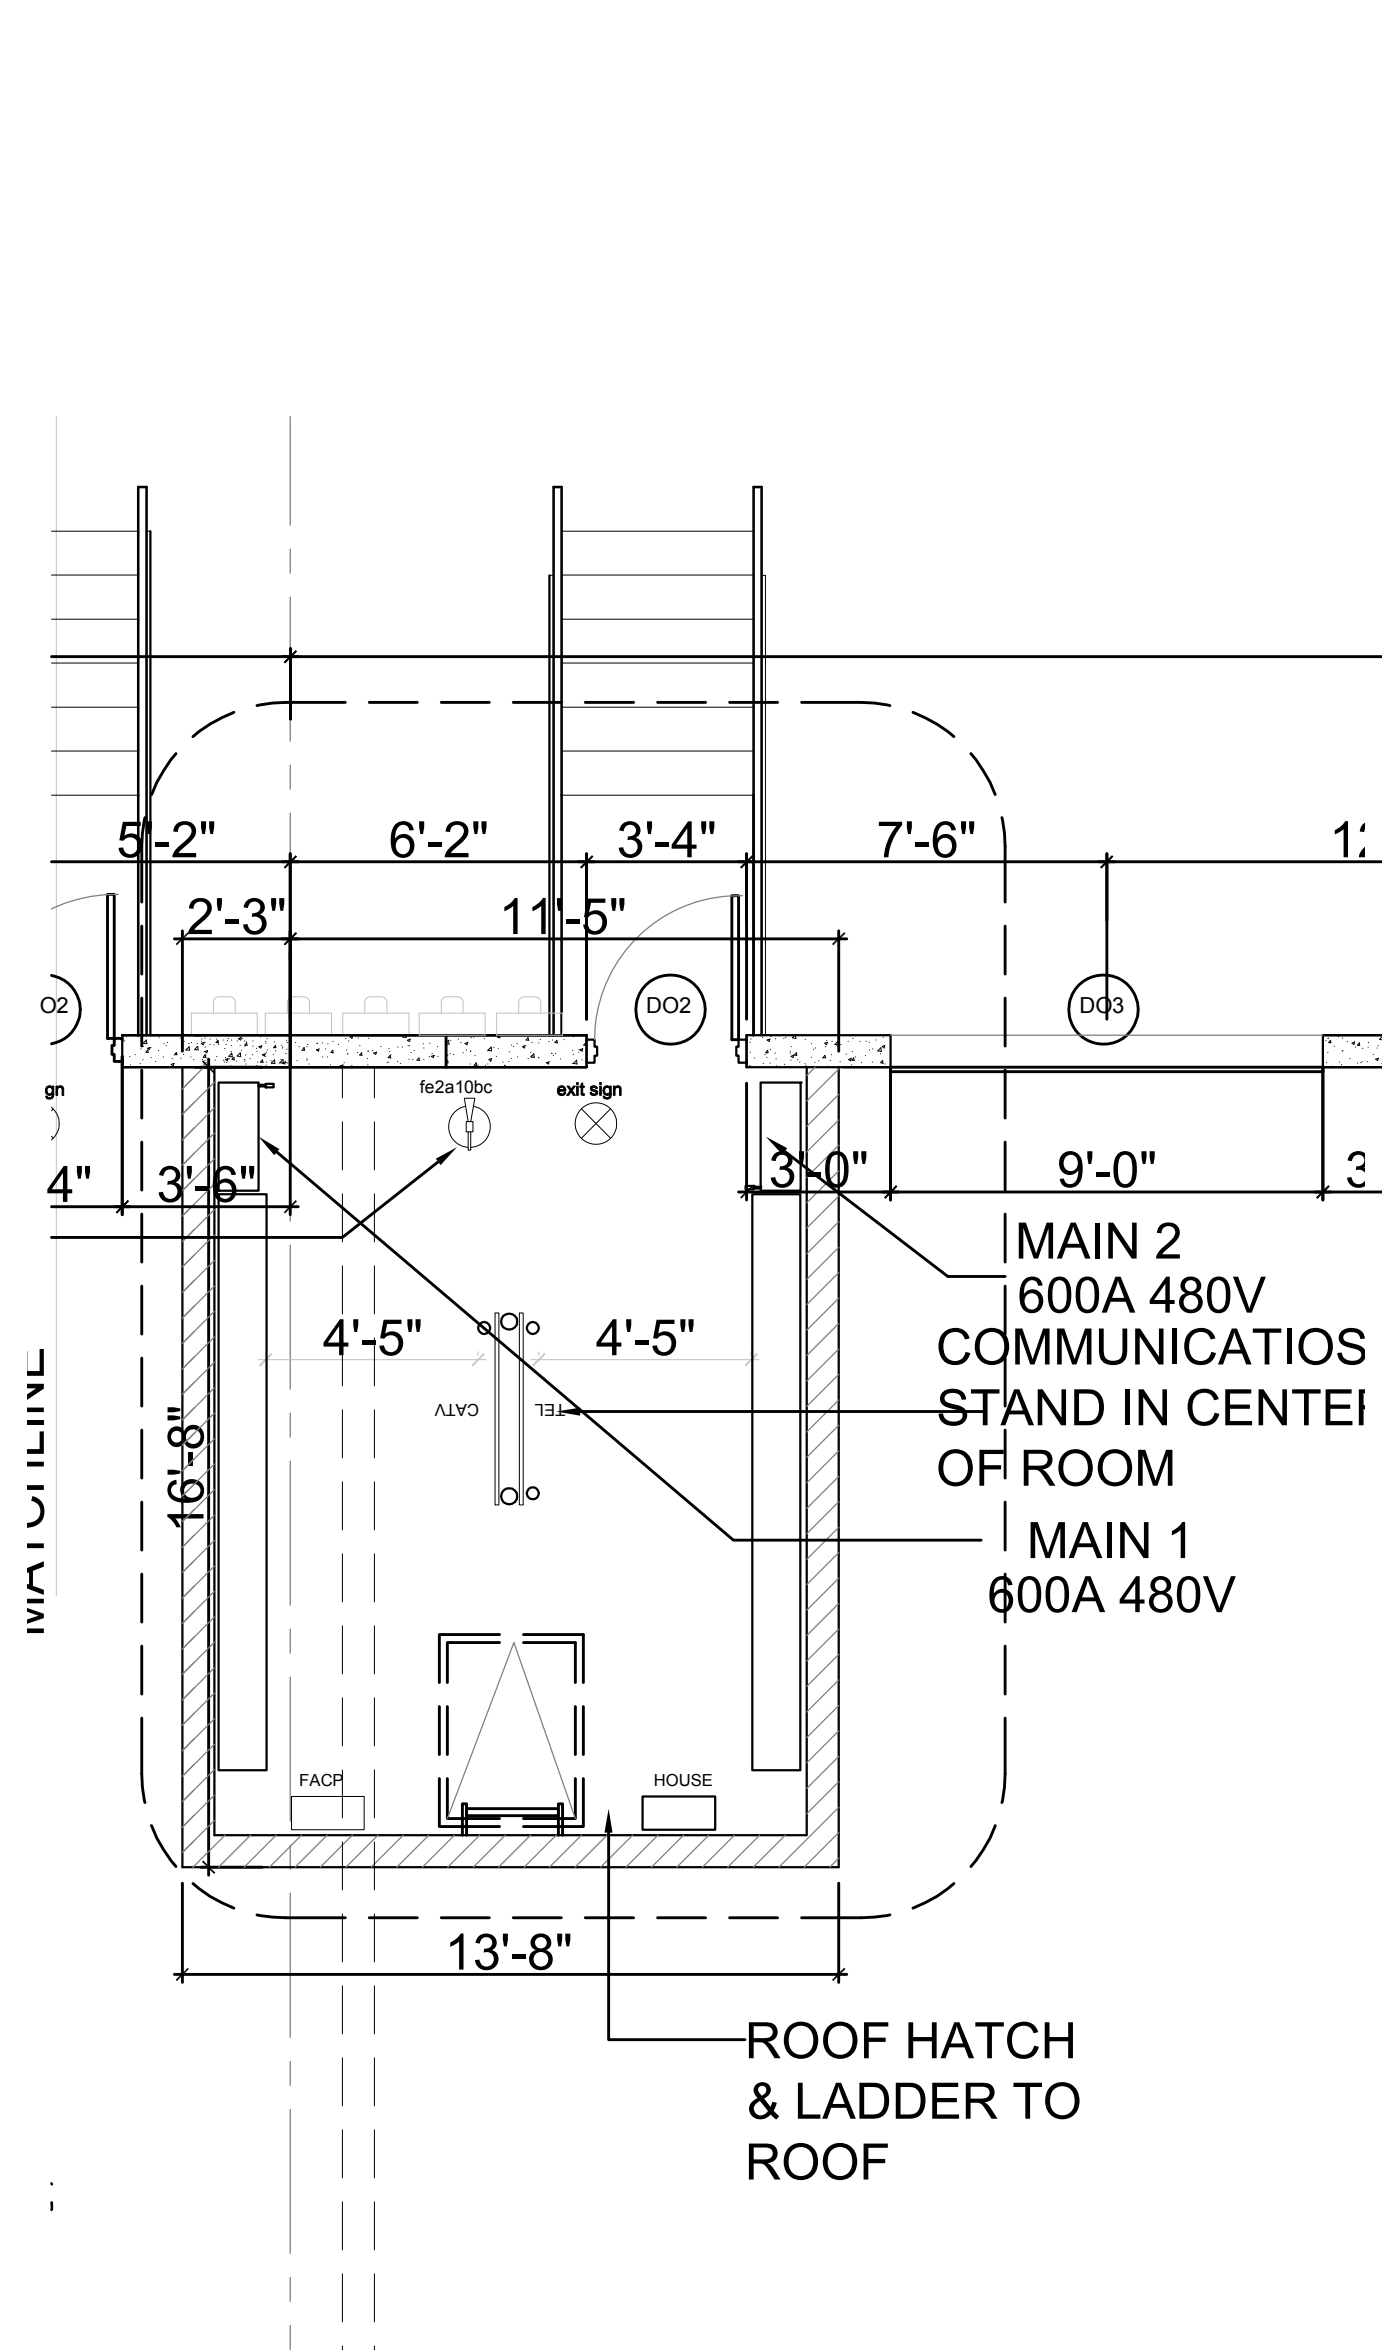

PLAN OF ELECTRICAL ROOM

PLAN OF FIRE SPRINKLER ROOM

PLAN CHECK 10-12-04
 BID SET 10-22-04

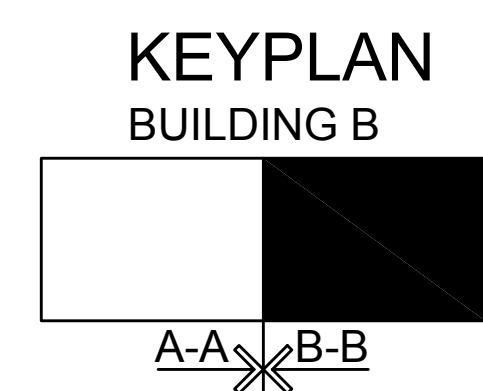

PROPOSED BUILDING B
 89,834 SF
 21.10 FIN.FLR

PARTIAL FLOOR PLAN "B-B"

ART CONCEPTS, Inc.
 AA 26000601
 2051 TRADE CENTER WAY
 NAPLES, FLORIDA 34109
 PHONE: 239-593-4633
 FAX: 239-592-0077

JACK GILLILAND ARCHITECT
 AR 0009984

ALICO COMMERCE CENTER
BUILDING B
JAMES F. KNOTT REALTY GROUP
 ONE TEXAS STATION COURT
 TIMONHUA, MADRID, ANI

PLAN CHECK
 CORRECTIONS
 PERMIT NO. -
 DATE: 12/7/2004
 PROJECT # 00/
 DRAWN BY: D.A.W.
 CHECKED BY:
 REVISIONS:

SHEET #:
A-1.2


SIZING TABLES 1106.2 & 1106.3 INTERPOLATED FOR 4.7"HR RATE			
STORM PIPE (DIA.)	ROOF AREA (SF.)		
	VERTICAL PIPE	HORIZONTAL PIPE (1/4"/FT. SLOPE)	HORIZONTAL PIPE (1/8"/FT. SLOPE)
2"	620	-	-
3"	1892	998	698
4"	3956	1872	1578
5"	7439	3335	2839
6"	11610	5335	4548
8"	24940	11518	8000
10"	-	20620	17610
12"	-	33225	28312
15"	-	59375	50575

PRIMARY ROOF DRAIN CALCULATION PER 2001 FLORIDA PLUMBING CODE			
ROOF DRAIN	ROOF SQ. FT.	STORM DRAINAGE PIPE SIZE (DIA. ")	
		VERTICAL	HORIZONTAL (1/8"/FT. SLOPE)
PRD-1	1780	2"	5"
PRD-2	155	2"	3"
PRD-3	920	3"	4"
PRD-4	810	3"	4"
PRD-5	310	2"	3"
PRD-6	485	2"	3"
PRD-7	425	2"	3"
PRD-8	641	3"	3"
PRD-9	1380	3"	4"
PRD-10	1430	3"	4"
PRD-11	2420	3"	5"
PRD-12	1790	3"	5"
PRD-13	1870	3"	5"
PRD-14	673	2"	3"
PRD-15	1420	3"	4"

FIGURE 1106.1 (INTERPOLATED) - 4.7" RAINFALL/HOUR

SECONDARY ROOF DRAIN CALCULATION PER 2001 FLORIDA PLUMBING CODE			
ROOF DRAIN	ROOF SQ. FT. (2XAREA)	STORM DRAINAGE PIPE SIZE (DIA. ")	
		VERTICAL	HORIZONTAL (1/8"/FT. SLOPE)
SRD-1	3560	4"	6"
SRD-2	310	2"	3"
SRD-3	1840	3"	5"
SRD-4	1620	3"	5"
SRD-5	620	3"	3"
SRD-6	972	3"	4"
SRD-7	850	3"	4"
SRD-8	1280	3"	4"
SRD-9	2760	4"	5"
SRD-10	2860	4"	6"
SRD-11	2840	4"	6"
SRD-12	3780	4"	6"
SRD-13	3740	4"	6"
SRD-14	1346	3"	4"
SRD-15	2840	4"	6"

FIGURE 1106.1 (INTERPOLATED) - 4.7" RAINFALL/HOUR

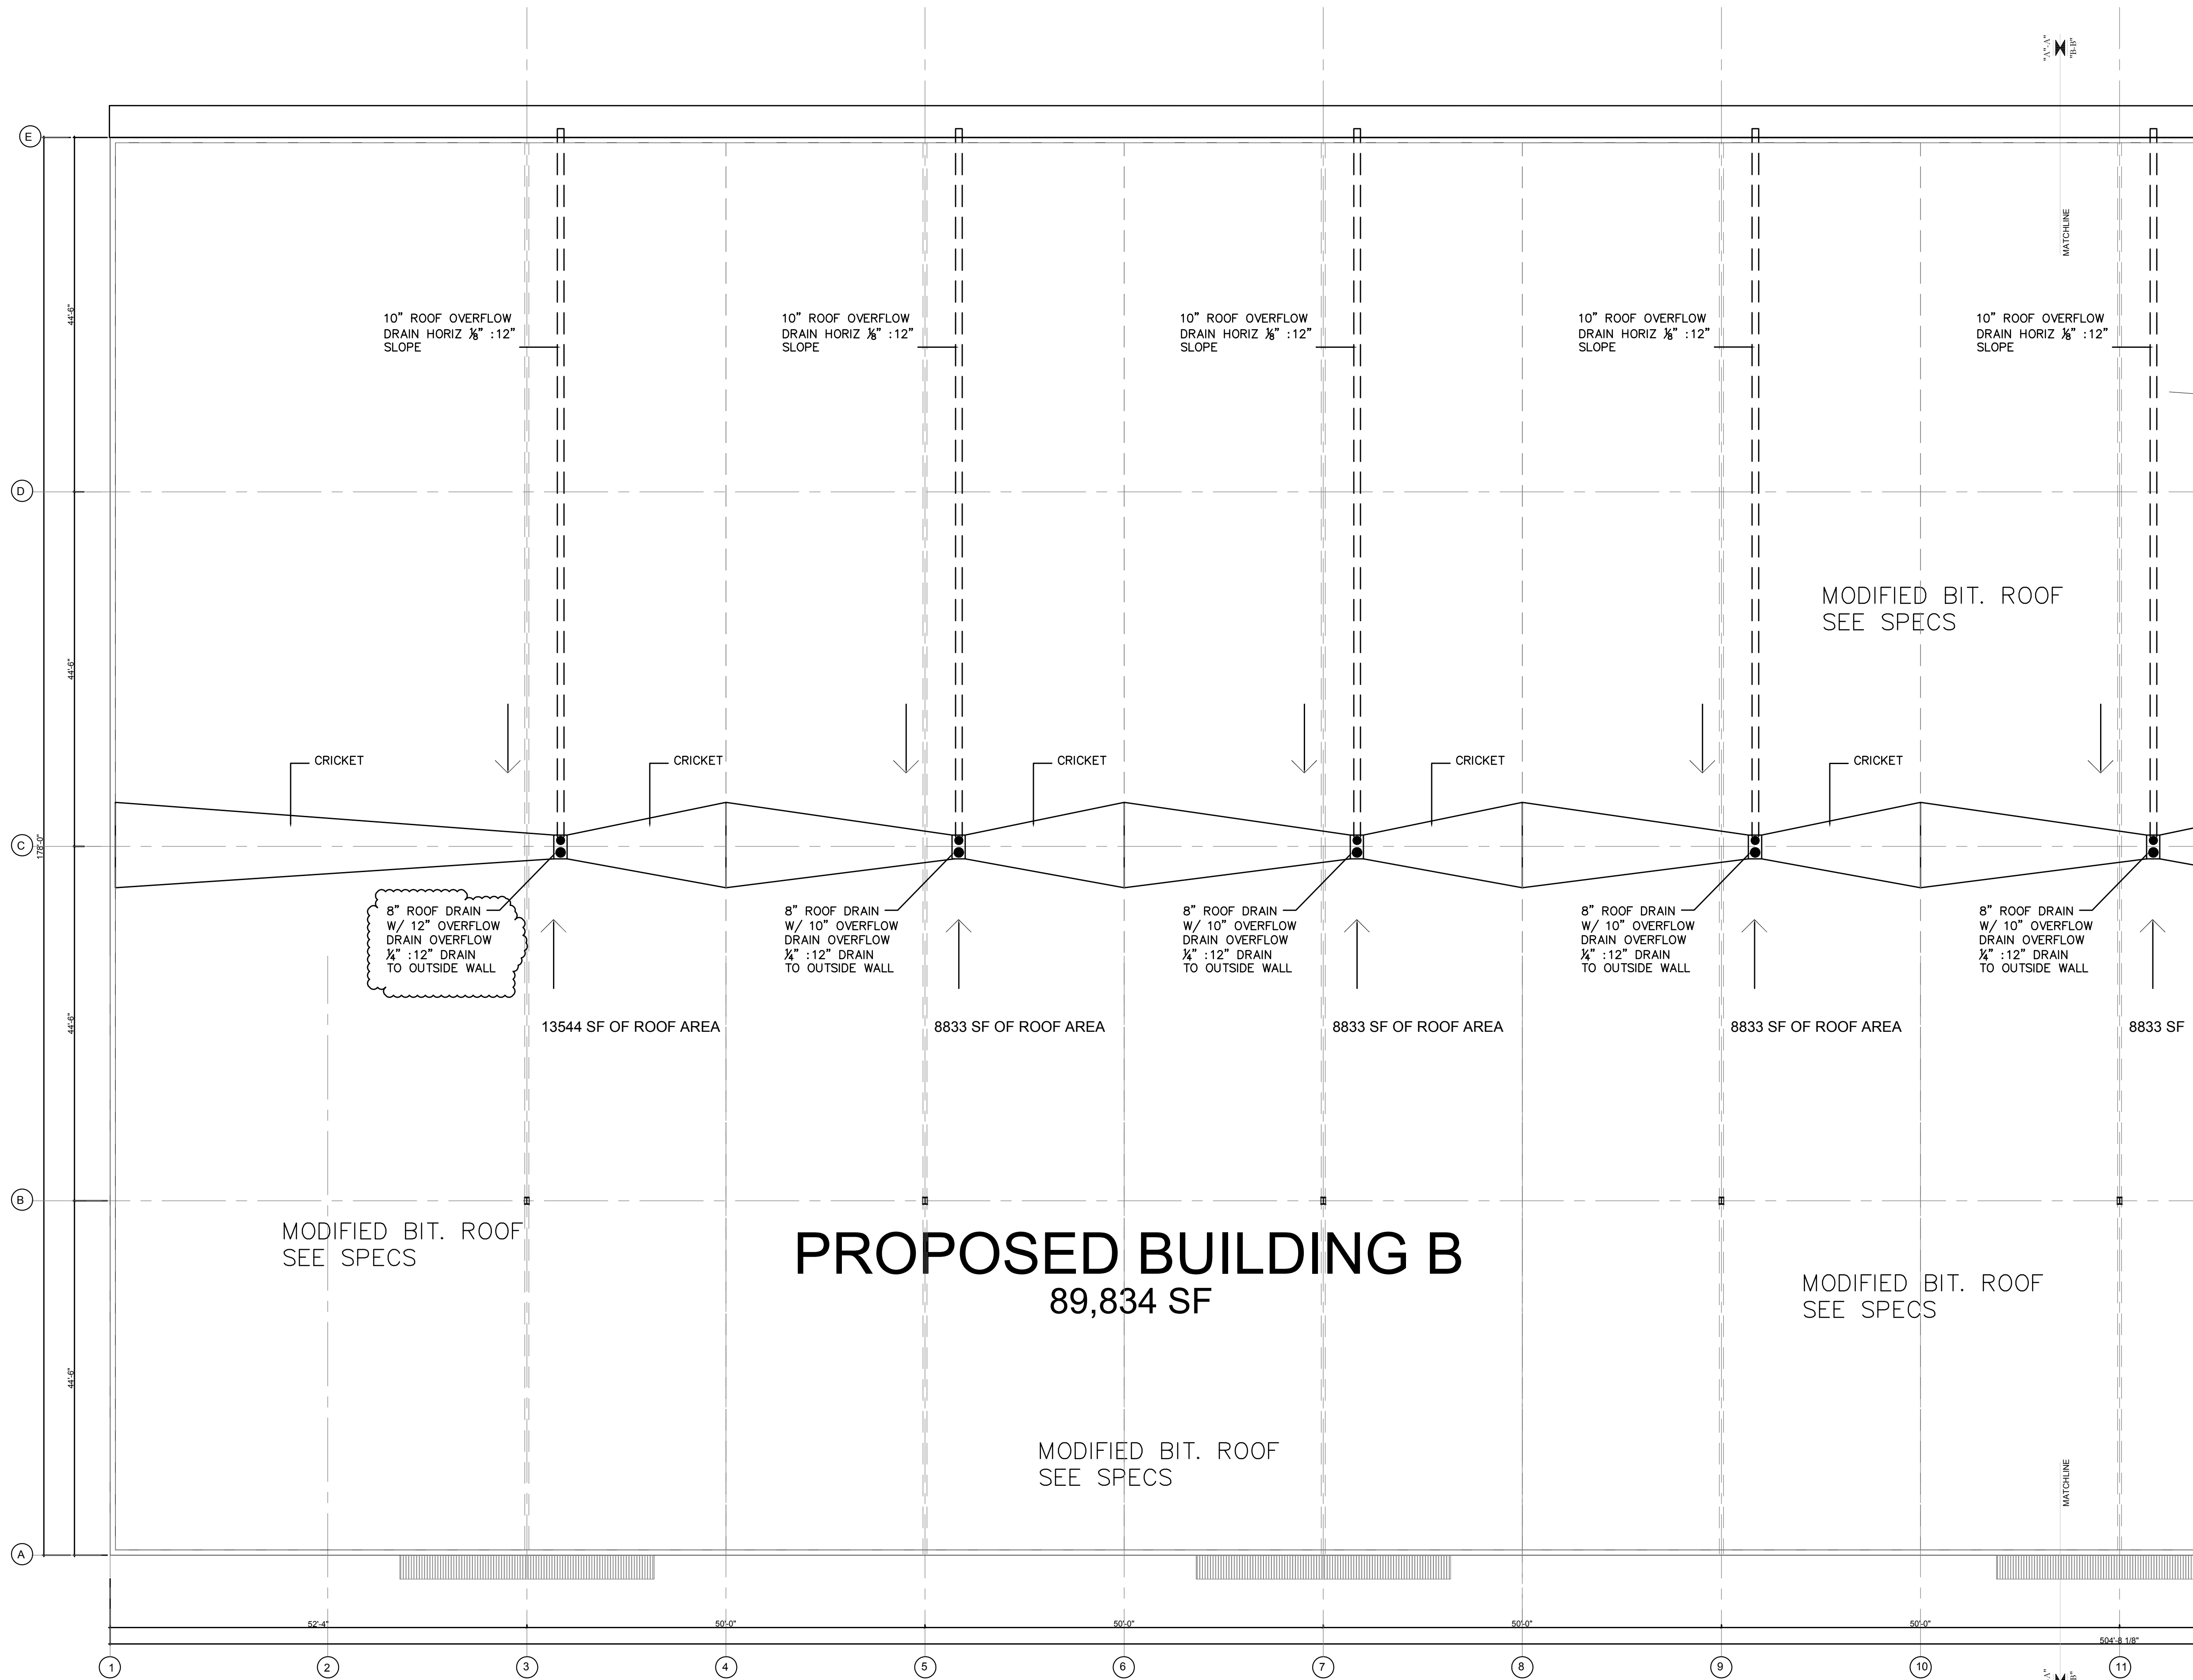

ART CONCEPTS, Inc.
 AA 26000601
 2051 TRADE CENTER WAY
 NAPLES, FLORIDA 34104
 PHONE: 239-593-4633
 FAX: 239-592-0077

ART CONCEPTS, INC. IS NOT RESPONSIBLE FOR THE CONSTRUCTION OF THE PROJECT AND SHALL BE RESPONSIBLE FOR THE PROVISION OF ALL NECESSARY PERMITS, ORDINANCES, OR NON-COMMERCIAL BUILDING DEPARTMENT APPROVALS IN ACCORDANCE WITH THE 2001 FLORIDA PLUMBING CODE AND STATE AND LOCAL CODES.

THE ARCHITECT RECORDS SHALL BE THE RESPONSIBILITY OF THE ARCHITECT AND SHALL BE THE ABSOLUTE RESPONSIBILITY OF THE ARCHITECT. THE ARCHITECT SHALL BE RESPONSIBLE FOR THE CONSTRUCTION OF THE PROJECT AND SHALL BE RESPONSIBLE FOR THE PROVISION OF ALL NECESSARY PERMITS, ORDINANCES, OR NON-COMMERCIAL BUILDING DEPARTMENT APPROVALS IN ACCORDANCE WITH THE 2001 FLORIDA PLUMBING CODE AND STATE AND LOCAL CODES.

JACK GILLILAND ARCHITECT
 AR 0009984


ALICO COMMERCE CENTER
BUILDING B
JAMES F. KNOTT REALTY GROUP
 ONE TEXAS STATION COURT
 TIMONHILL, MARVANI

PLAN CHECK
 CORRECTIONS
 PERMIT NO. -
 DATE: 12/7/2004
 PROJECT #: 00/
 DRAWN BY: D.A.W.
 CHECKED BY:
 REVISIONS:

SHEET #:
A-1.3

PLAN CHECK 10-12-04
 BID SET 10-22-04

PARTIAL ROOF PLAN "A-A"

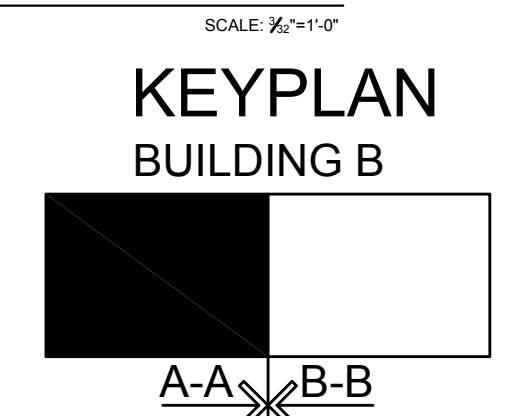

**SIZING TABLES 1106.2 & 1106.3
INTERPOLATED FOR 4.7"/HR RATE**

STORM PIPE (DIA.)	ROOF AREA (SF.)		
	VERTICAL PIPE	HORIZONTAL PIPE (1/4"/FT. SLOPE)	HORIZONTAL PIPE (1/8"/FT. SLOPE)
2"	620	-	-
3"	1892	998	698
4"	3956	1872	1578
5"	7439	3335	2839
6"	11610	5335	4548
8"	24940	11518	8000
10"	-	20620	17610
12"	-	33225	28312
15"	-	59375	50575

**PRIMARY ROOF DRAIN CALCULATION
PER 2001 FLORIDA PLUMBING CODE**


ROOF DRAIN	ROOF SQ. FT.	STORM DRAINAGE PIPE SIZE (DIA. ")	
		VERTICAL	HORIZONTAL (1/8"/FT. SLOPE)
PRD-1	1780	2"	5"
PRD-2	155	2"	3"
PRD-3	920	3"	4"
PRD-4	810	3"	4"
PRD-5	310	2"	3"
PRD-6	485	2"	3"
PRD-7	425	2"	3"
PRD-8	641	3"	3"
PRD-9	1380	3"	4"
PRD-10	1430	3"	4"
PRD-11	2420	3"	5"
PRD-12	1790	3"	5"
PRD-13	1870	3"	5"
PRD-14	673	2"	3"
PRD-15	1420	3"	4"

FIGURE 1106.1 (INTERPOLATED) - 4.7" RAINFALL/HOUR

**SECONDARY ROOF DRAIN CALCULATION
PER 2001 FLORIDA PLUMBING CODE**


ROOF DRAIN	ROOF SQ. FT. (2XAREA)	STORM DRAINAGE PIPE SIZE (DIA. ")	
		VERTICAL	HORIZONTAL (1/8"/FT. SLOPE)
SRD-1	3560	4"	6"
SRD-2	310	2"	3"
SRD-3	1840	3"	5"
SRD-4	1620	3"	5"
SRD-5	620	3"	3"
SRD-6	972	3"	4"
SRD-7	850	3"	4"
SRD-8	1280	3"	4"
SRD-9	2760	4"	5"
SRD-10	2860	4"	6"
SRD-11	2840	4"	6"
SRD-12	3780	4"	6"
SRD-13	3740	4"	6"
SRD-14	1346	3"	4"
SRD-15	2840	4"	6"

FIGURE 1106.1 (INTERPOLATED) - 4.7" RAINFALL/HOUR

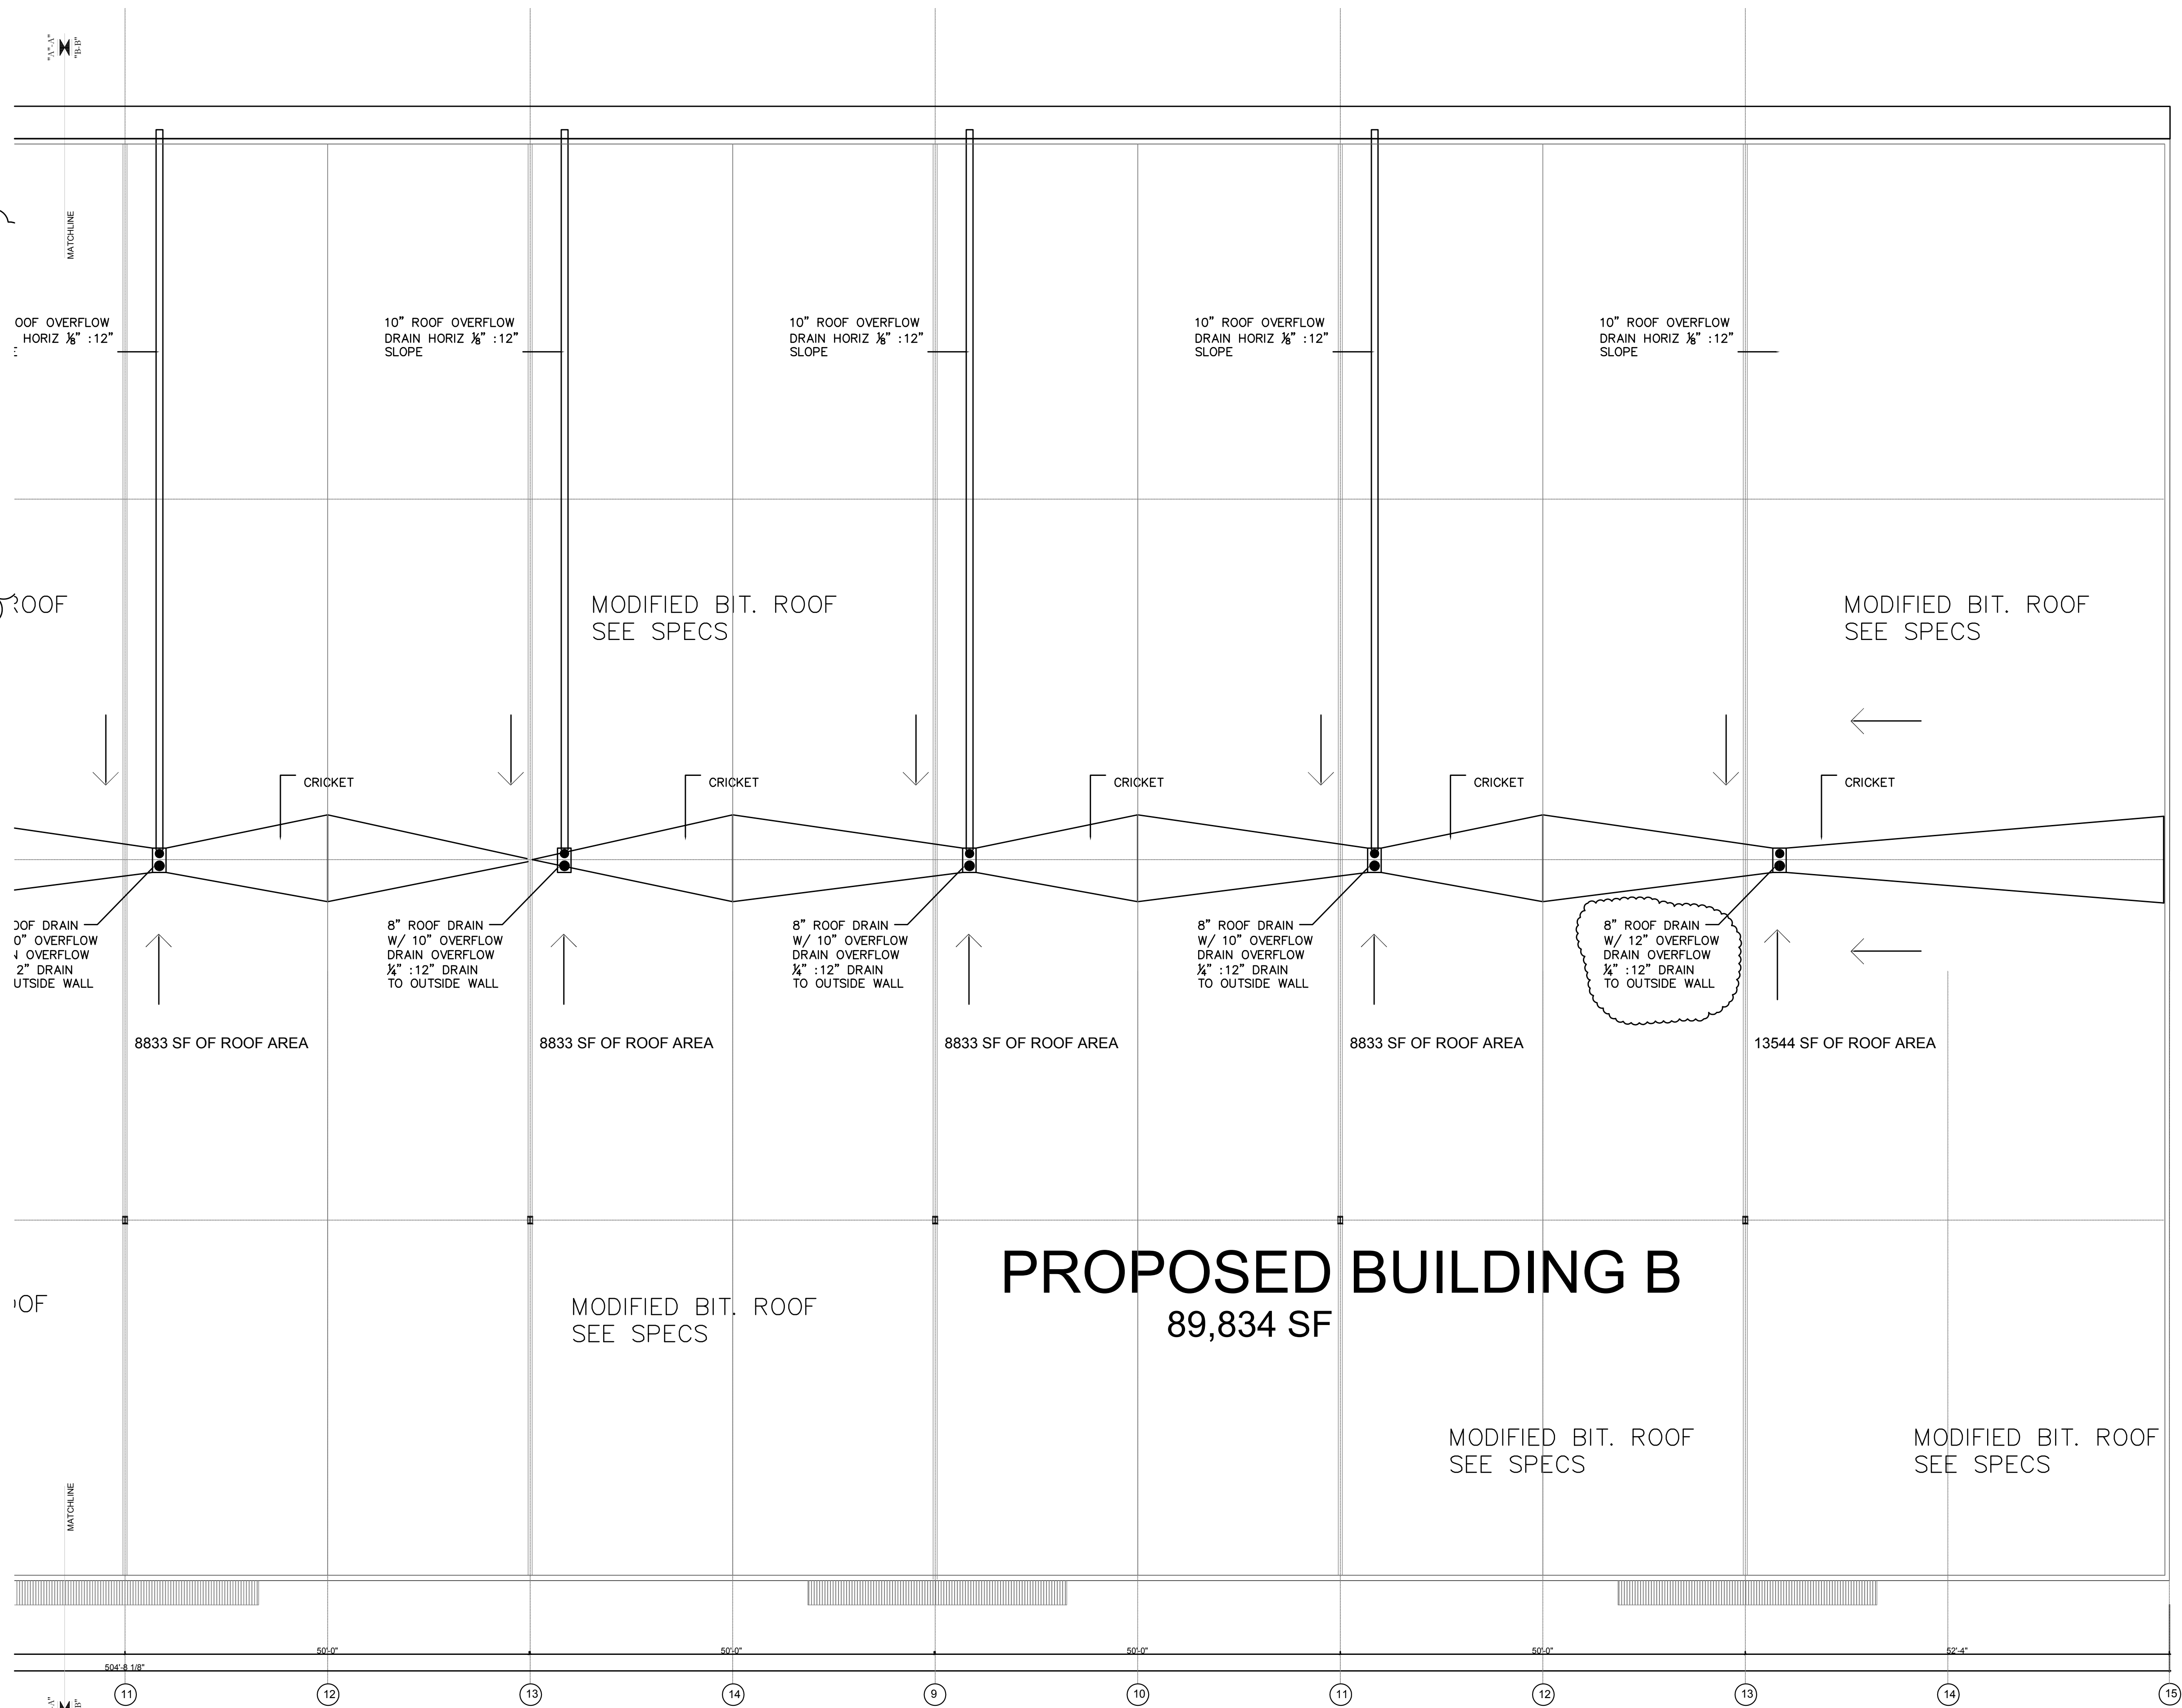


1/4" = 1'-0"

PLAN CHECK 10-12-04
BID SET 10-22-04

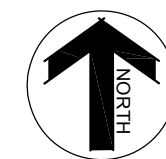

PARTIAL ROOF PLAN "B-B"

KEY PLAN
BUILDING B

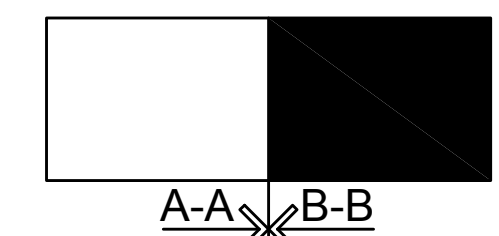

ART CONCEPTS, Inc.
AA 26000601
2051 TRADE CENTER WAY
FLORIDA
NAPLES 239-593-4633
PHONE 239-592-0077
FAX

ART CONCEPTS, INC. IS NOT RESPONSIBLE FOR THE CONSTRUCTION OF THIS PROJECT. THESE PLANS, SPECIFICATIONS AND OTHER INFORMATION ARE TO BE USED BY THE CONTRACTOR AND OTHER PROFESSIONALS IN THE FIELD. THESE PLANS, SPECIFICATIONS AND OTHER INFORMATION ARE TO BE USED BY THE CONTRACTOR AND OTHER PROFESSIONALS IN THE FIELD. THESE PLANS, SPECIFICATIONS AND OTHER INFORMATION ARE TO BE USED BY THE CONTRACTOR AND OTHER PROFESSIONALS IN THE FIELD. THESE PLANS, SPECIFICATIONS AND OTHER INFORMATION ARE TO BE USED BY THE CONTRACTOR AND OTHER PROFESSIONALS IN THE FIELD.

**JACK GILLILAND ARCHITECT
AR 0009984**

**ALICO COMMERCE CENTER
BUILDING B**
JAMES F. KNOTT REALTY GROUP
ONE TEXAS STATION COURT
TIMONILUM, MARYLAND

PLAN CHECK
CORRECTIONS
PERMIT NO. -
DATE: 12/7/2004
PROJECT #: 00/
DRAWN BY: D.A.W.
CHECKED BY:
REVISIONS:

SHEET #:
A-1.4


ART CONCEPTS, INC. HEREBY REPRESENTS ITS COMMON LAW CONTRACT AND OTHER PROPERTY RIGHTS IN THESE ARCHITECTURAL AND ENGINEERING DRAWINGS AND PLANS AND NOT TO BE REPRODUCED, CHANGED OR COPIED IN ANY FORM OR MANNER WITHOUT THE WRITTEN CONSENT OF ART CONCEPTS, INC. THE CONTRACTOR SHALL BE RESPONSIBLE FOR ALL OVERSIGHT AND CONDITIONS OF THE JOB AND P.L.C. MUST BE NOTICED IN ADVANCE OF ANY MODIFICATION FROM THE ORIGINAL CONTRACT AND SPECIFICATIONS SHOWN BY THESE DRAWINGS. ALL CONSTRUCTION SHALL BE IN ACCORDANCE WITH THE MOST RECENT BUILDING CODES AND STATE AND LOCAL ORDINANCES.

THE OWNER OR CONTRACTOR SHALL BE RESPONSIBLE FOR THE CONSTRUCTION OF THE PROJECT AND STRICTLY FOLLOW THE LOCAL BUILDING CODES AND ORDINANCES. THE ARCHITECT AND ENGINEER SHALL BE THE SOLE RESPONSIBILITY OF THE OWNER GENERAL CONTRACTOR OR THESE INDICATORS.

THESE CONSTRUCTION DOCUMENTS SHALL BE THE SOLE BASIS OF OBTAINING A PERMIT AND A CONSTRUCTION GUIDE AND ARE NOT APPROVED UNLESS SIGNED AND SEALED BY THE ENGINEER.

JACK GILLILAND ARCHITECT
 AR 0009984

ALICO COMMERCE CENTER
BUILDING B
JAMES F. KNOTT'S REALTY GROUP
 ONE TEXAS STATION COURT
 TITIMONIIIIM MAPVI ANID

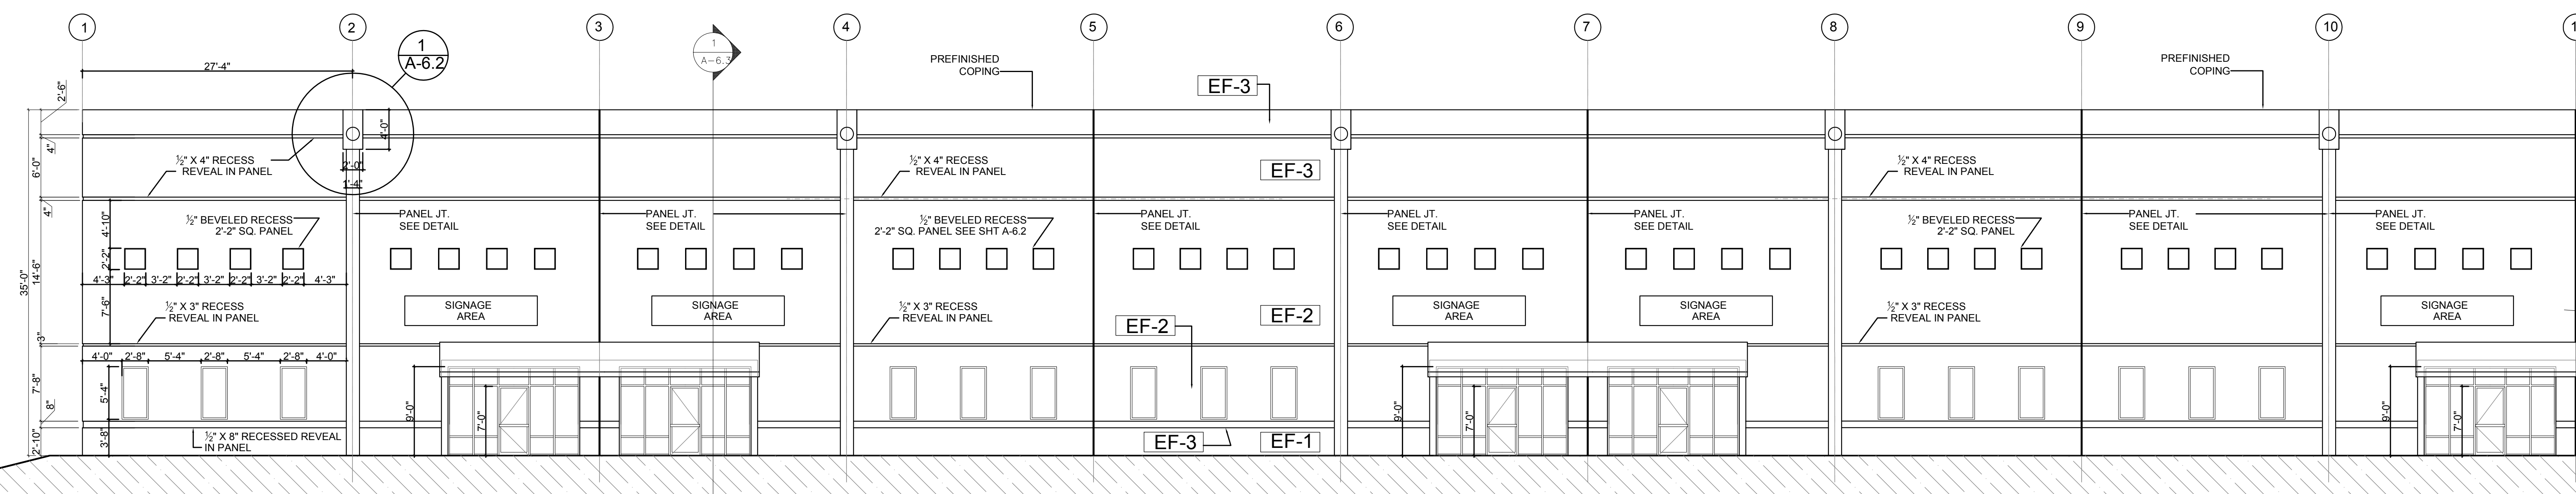


PARTIAL FRONT ELEVATION "A-A"
 SCALE: 1/8"=1'-0"

CONTRACTOR TO SUPPLY 10 YEAR WARRANTY FOR LABOR & MATERIAL TO U-STORE-IT AS PER SHERWIN WILLIAMS SPECIFICATION SEE SHERWIN WILLIAMS FOR COMPLETE APPLICATION SPECIFICATION FOR PRIMER /FILLER /PAINTING

The Sherwin-Williams Company
 Cleveland, OH 44115
 A-100 Exterior Latex Flat (M), Satin (A82), and Gloss (M)
 Description
 A-100 Exterior Latex Flat, Satin and Gloss are our best quality, 100% acrylic latex house paints. EXISTING TILT-UP WALL
 Characteristics
 Product: Flat Satin Gloss
 Color: All exterior ColorAnswers®
 Colors
 Coverage, sq ft/gal: 400 400 400
 Mils wet/mils dry 4/1.3 4/1.3 4/1.3
 Drying Schedule: (temperature and humidity dependent)
 @ 77°F, 50% RH, and 4 mils wet:
 To touch: 1 hour 1 hour
 To recoat: 4 hours 4 hours 24 hours
 Finish (units): 0-5 @ 85010-20 @ 60035-45

C@600
 Flash Point (PMCC): none none none
 VOC (as packaged): White
 grams/liter 58 38 49
 lbs/gal 0.48 0.32 0.41
 Volume Solids: 32% 33% 33%
 Weight per Gallon: 11.0 lb 10.4 lb 10.0 lb
 Temperature: 50°F minimum, 90°F maximum (air, surface, and material), at least 50°F above dew point
 Relative humidity: 85% maximum
 The following is a guide. Changes in pressures and tip sizes may be needed for proper spray characteristics. Always purge spray equipment before use with listed reducer. Any reduction must be compatible with the existing environmental and application conditions.


Reducer/Clean Up Water
 Brushnylon/polyester
 RollerUse a 3/8" - 3/4" synthetic
 Spray-Airless
 Pressure2000 psi
 Tip 0 15-.021
 Spray-Conventional
 Air Pressure 40-60 psi
 Fluid Pressure 15-20 psi
 Cap/Tip704/FX
 Specifications
 Aluminum & Aluminum Siding
 2 cts. A-100 Exterior Latex Finish
 Block
 1 ct.
 2 cts. Brick
 1 ct. Loxon Conditioner
 2 cts. A-1 00 Exterior Latex Finish
 2 cts. A-1 00 Exterior Latex Finish
 Galvanized Steel
 2 cts. A-1 00 Exterior Latex Finish
 Masonry/Stucco
 1 ct. Loxon Ext. Acrylic Masonry Primer, or
 1 ct. Loxon Conditioner
 2 cts. A-100 Exterior Latex Finish
 Steel, alkyd primer
 1 ct. Kern Kromik Universal Metal Primer
 2 cts. A-1 00 Exterior Latex Finish
 Steel, latex primer
 1 ct. DTM Acrylic Primer/Finish
 2 cts. A-100 Exterior Latex Finish
 PrepRite Block Filler
 A-100 Exterior Latex Finish

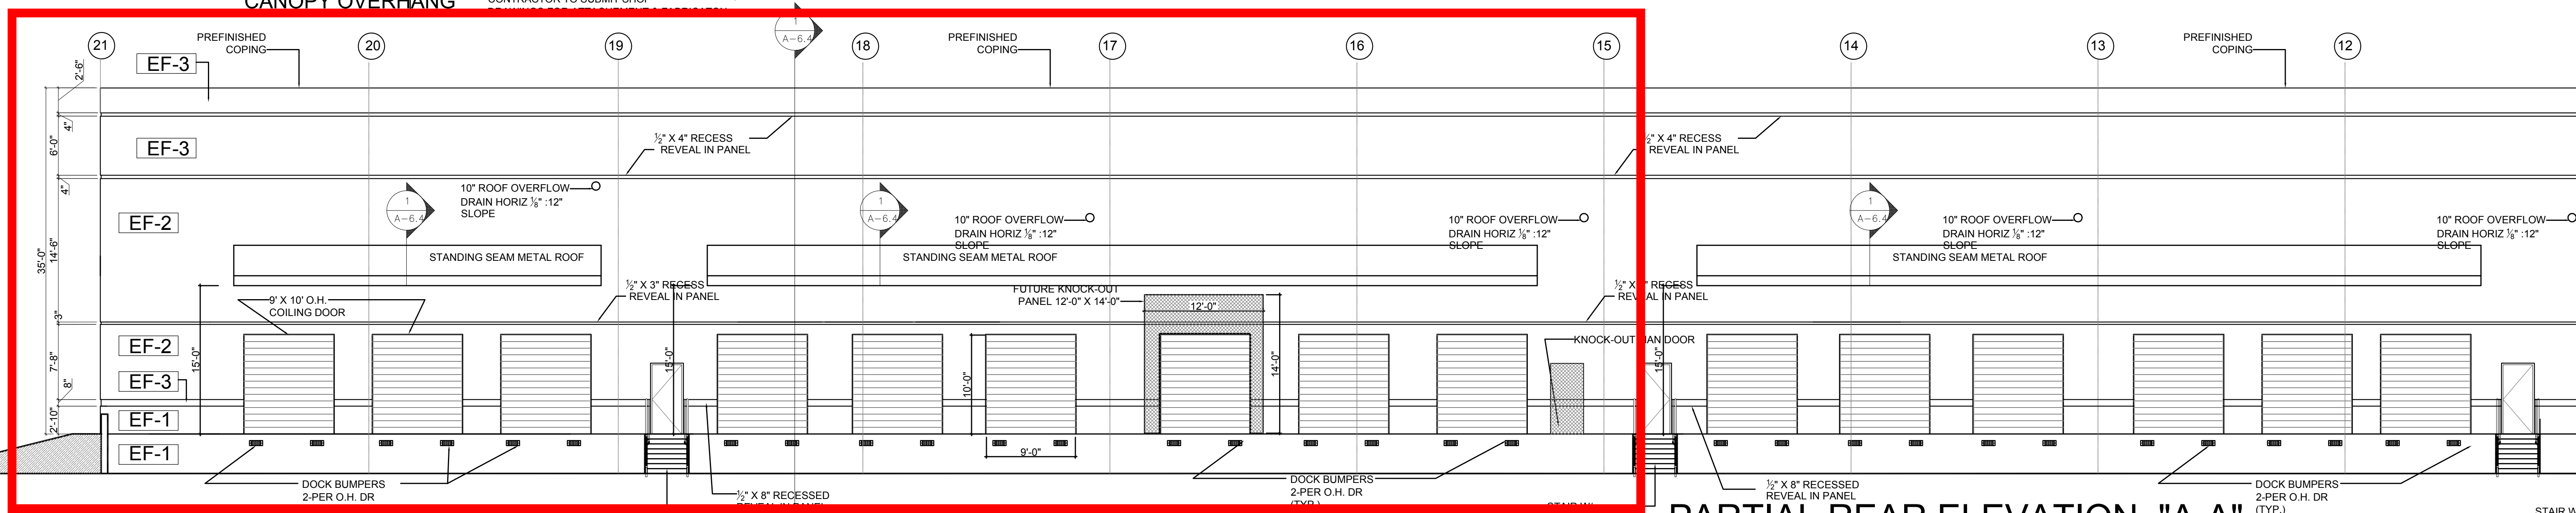


PARTIAL REAR ELEVATION "A-A"
 SCALE: 1/8"=1'-0"

EXTERIOR FINISH SCHEDULE			
INDICATOR	PAINT MFG	COLOR	NUMBER
EF-1	SHERWIN WILLIAMS 100 SERIES		
EF-2	SHERWIN WILLIAMS 100 SERIES		
EF-3	SHERWIN WILLIAMS 100 SERIES		
EF-4	SHERWIN WILLIAMS 100 SERIES		
EF-	SHERWIN WILLIAMS 100 SERIES		
EF-	SHERWIN WILLIAMS 100 SERIES		
EF-	SHERWIN WILLIAMS 100 SERIES		

PLAN CHECK
 CORRECTIONS
 PERMIT NO. -
 DATE: 12/7/2004
 PROJECT # 00/
 DRAWN BY: D.A.W.
 CHECKED BY:
 REVISIONS:
 SHEET #

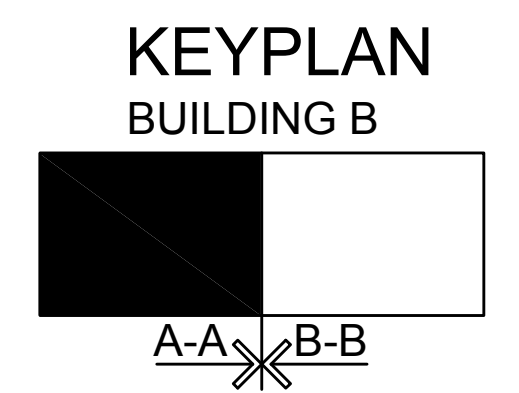

PLAN CHECK 10-12-04
BID SET 10-22-04

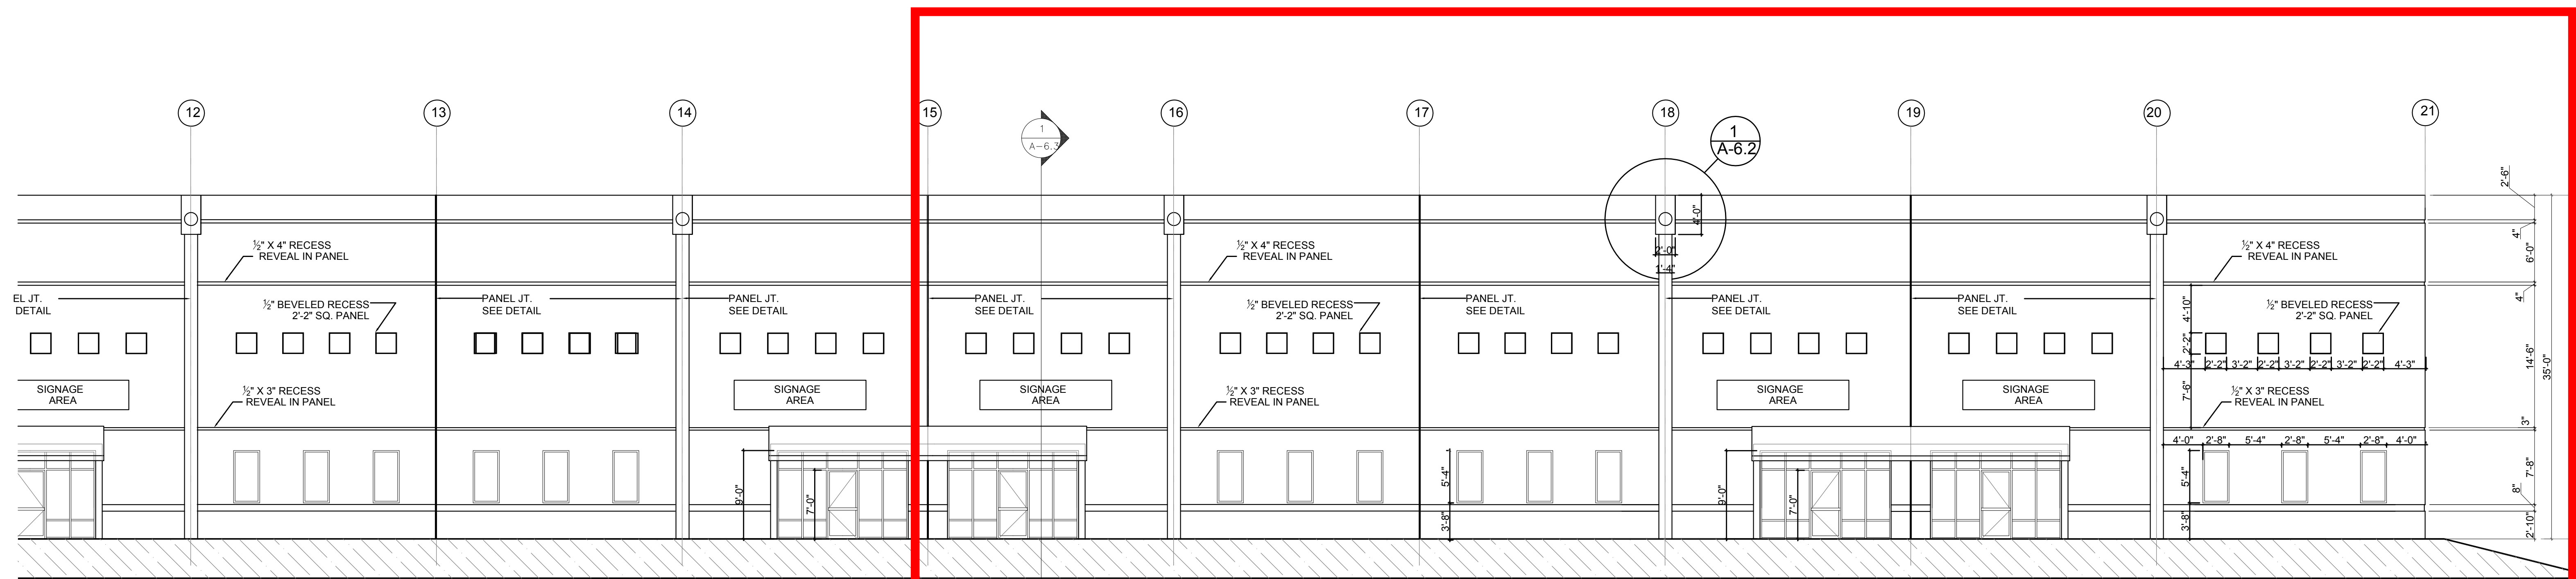

CONTRACTOR TO SUPPLY 10 YEAR WARRANTY FOR LABOR & MATERIAL TO U-STORE-IT AS PER SHERWIN WILLIAMS SPECIFICATION SEE SHERWIN WILLIAMS FOR COMPLETE APPLICATION SPECIFICATION FOR PRIMER /FILLER /PAINTING


The Sherwin-Williams Company
Cleveland, OH 44115
A-100 Exterior Latex Flat (M), Satin (A82), and Gloss (M)
Description
A-100 Exterior Latex Flat, Satin and Gloss are our best quality, 100% acrylic latex house paints.
Characteristics
Product: Flat Satin Gloss
Color: All exterior ColorAnswers®
Colors
Coverage, sq ft/gal: 400 400 400
Mils wet/mils dry 4/1.3 4/1.3 4/1.3
Drying Schedule: (temperature and humidity dependent)
@77°F, 50% RH, and 4 mils wet:
To touch: 1 hour 1 hour 1 hour
To recoat: 4 hours 4 hours 24 hours
Finish (units): 0-5 @ 85010-20 @ 60035-45

C@600
Flash Point (PMCC): none none none
VOC (as packaged): White
grams/liter 58 38 49
lbs/gal 0.49 0.32 0.41
Volume Solids: 32% 33% 33%
Weight per Gallon: 11.0 lb 10.4 lb 10.0 lb
Temperature: 50°F minimum, 90°F maximum, (air, surface, and material), at least 50°F above dew point
Relative humidity: 85% maximum
The following is a guide. Changes in pressures and tip sizes may be needed for proper spray characteristics. Always purge spray equipment before use with listed reducer. Any reduction must be compatible with the existing environmental and application conditions.

Reducer/Clean Up Water
Brushnylon/polyester
RollerUse a 3/8" - 3/4" synthetic
Spray-Airless
Pressure2000 psi
Tip 0 15- 021
Spray Conventional
Air Pressure 40-60 psi
Fluid Pressure 15-20 psi
Cap/Tip704/FX
Specifications
Aluminum & Aluminum Siding
2 cts. A-100 Exterior Latex Finish
Block
1 ct.
2 cts.
Brick

1 ct. Loxon Conditioner
2 cts. A-1 00 Exterior Latex Finish
Galvanized Steel
2 cts. A-1 00 Exterior Latex Finish
Masonry/Stucco
1 ct. Loxon Ext. Acrylic Masonry Primer, or
1 ct. Loxon Conditioner
2 cts. A-100 Exterior Latex Finish
Steel, alkyd primer
1 ct. Kern Kromik Universal Metal Primer
2 cts. A-1 00 Exterior Latex Finish
Steel, latex primer
1 ct. DTM Acrylic Primer/Finish
2 cts. A-100 Exterior Latex Finish
PrepRite Block Filler
A-100 Exterior Latex Finish


PARTIAL FRONT ELEVATION "B-B"
SCALE: 1/8"=1'-0"

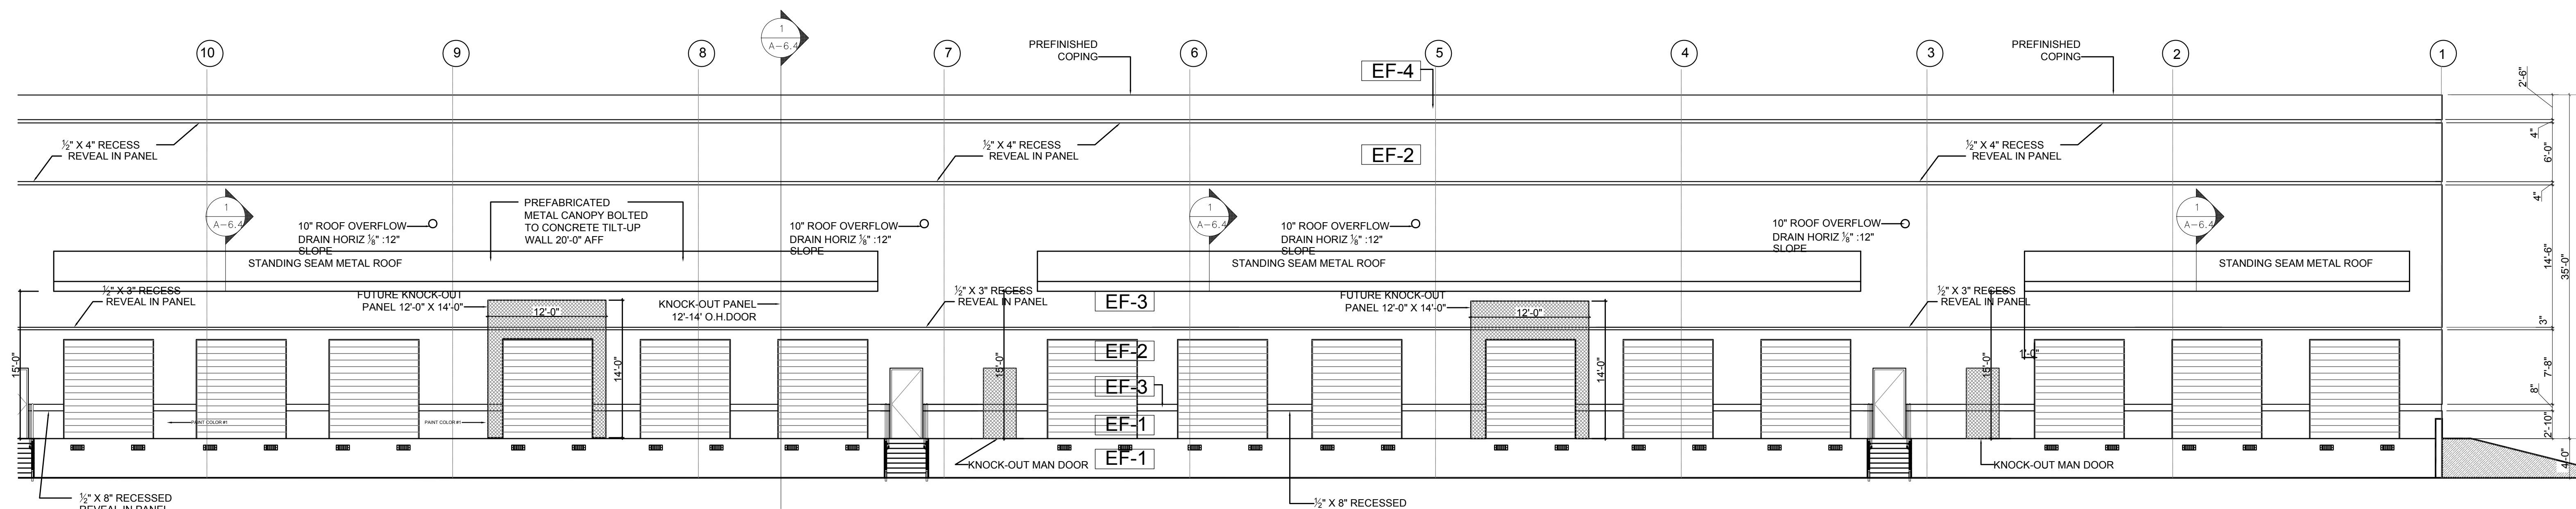

PARTIAL REAR ELEVATION "B-B"

INDICATOR	PAINT MFG	COLOR	NUMBER
EF-1	SHERWIN WILLIAMS 100 SERIES		
EF-2	SHERWIN WILLIAMS 100 SERIES		
EF-3	SHERWIN WILLIAMS 100 SERIES		
EF-4	SHERWIN WILLIAMS 100 SERIES		
EF-	SHERWIN WILLIAMS 100 SERIES		
EF-	SHERWIN WILLIAMS 100 SERIES		
EF-	SHERWIN WILLIAMS 100 SERIES		

PLAN CHECK 10-12-04
BID SET 10-22-04

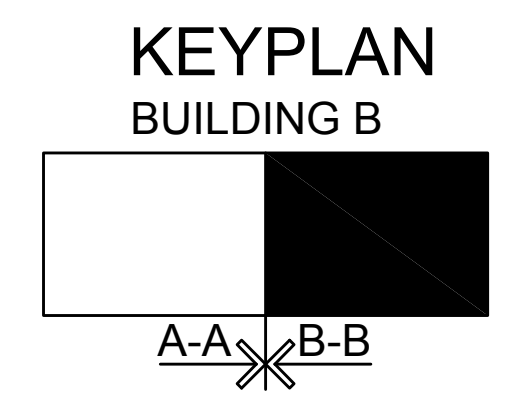

ART CONCEPTS, Inc.
AA 26000601
2051 TRADE CENTER WAY
NAPLES FLORIDA
PHONE: 239-593-4633
FAX: 239-592-0077

JACK GILLILAND ARCHITECT
AR 0009984

ALICO COMMERCE CENTER
BUILDING B
JAMES F. KNOTT REALTY GROUP
ONE TEXAS STATION COURT
TIMONIUM, MARYLAND

PLAN CHECK
CORRECTIONS
PERMIT NO. -
DATE: 12/7/2004
PROJECT #: 00/
DRAWN BY: D.A.W.
CHECKED BY:
REVISIONS:
SHEET #:
A-4.2

CONTRACTOR TO SUPPLY 10 YEAR WARRANTY FOR LABOR & MATERIAL TO U-STORE-IT AS PER SHERWIN WILLIAMS SPECIFICATION SEE SHERWIN WILLIAMS FOR COMPLETE APPLICATION SPECIFICATION FOR PRIMER /FILLER /PAINTING

The Sherwin-Williams Company
Cleveland, OH 44115

A-100 Exterior Latex Flat (M), Satin (A82), and Gloss (M) Description

A-100 Exterior Latex Flat, Satin and Gloss are our best quality, 100% acrylic latex house paints.

Characteristics
Product: Flat Satin Gloss
Color: All exterior ColorAnswersO
Colors

Coverage, sq ft/gal: 400 400 400
Mils wet/mils dry 4/1.3 4/1.3 4/1.3

Drying Schedule: (temperature and humidity dependent)
@)770F, 50% RH, and 4 mils wet:
To touch: 1 hour 1 hour 1 hour
To recoat: 4 hours 4 hours 24 hours
Finish (units): 0-5 @ 85010-20 @ 60035-45

C@600
Flash Point (PMCC): none none none
VOC (as packaged): White
grams/liter 58 38 49
lbs/gal 0.48 0.32 0.41
Volume Solids: 32%2%33%2% 33%2%
Weight per Gallon: 11.0 lb 10.4 lb 10.0 lb

Temperature: 50OF minimum, 90OF maximum, (air, surface, and material), at least 50F above dew point
Relative humidity: 85% maximum

The following is a guide. Changes in pressures and tip sizes may be needed for proper spray characteristics. Always purge spray equipment before use with listed reducer. Any reduction must be compatible with the existing environmental and application conditions.

Reducer/Clean Up Water
Brushnylon/polyester
RollerUse a 3/8" - 3/4" synthetic
Spray-Airless
Pressure2000 psi
Tip0 15-.021
Spray-Conventional
Air Pressure 40-60 psi
Fluid Pressure 15-20 psi
Cap/Tip704/FX

Specif ications
Aluminum & Aluminum Siding
2 cts. A-100 Exterior Latex Finish
Block
1 ct.
2 cts.
Brick

1 ct. Loxon Conditioner
2 cts. A-1 00 Exterior Latex Finish
2 cts. A-1 00 Exterior Latex Finish
Galvanized Steel
2 cts. A-1 00 Exterior Latex Finish
Masonry/Stucco
1 ct. Loxon Ext. Acrylic Masonry Primer, or
1 ct. Loxon Conditioner
2 cts. A-100 Exterior Latex Finish
Steel, alkyl primer
1 ct. Kern Kromik Universal Metal Primer
2 cts. A-1 00 Exterior Latex Finish
Steel, latex primer
1 ct. DTM Acrylic Primer/Finish
2 cts. A-100 Exterior Latex Finish
PrepRite Block Filler
A-100 Exterior Latex Finish

ART CONCEPTS, INC. RESERVES ALL RIGHTS AND RESERVES THE RIGHT TO MAKE CHANGES TO THESE PLANS, SPECIFICATIONS AND CONDITIONS WITHOUT NOTICE. THESE PLANS AND SPECIFICATIONS ARE NOT TO BE REPRODUCED, COPIED OR COPIED IN ANY FORM OR MANNER WITHOUT THE WRITTEN CONSENT OF ART CONCEPTS, INC. CONTRACTOR SHALL BE RESPONSIBLE FOR ALL LABOR AND CONDITIONS OF THE JOB AND I.D.C. MUST BE NOTICED IN ADVANCE OF ANY VIOLATION OF THE SPECIFICATIONS AND CONDITIONS. ALL CONSTRUCTION SHALL BE IN ACCORDANCE WITH THE FLORIDA BUILDING CODE AND STATE AND LOCAL CODES.

THE OWNER OR CONTRACTOR SHALL BE TOTALLY RESPONSIBLE FOR THE CONSTRUCTION OF THIS PROJECT AND STRICTLY FOLLOW THE LOCAL BUILDING CODES AND ORDINANCES. THEY SHALL ALSO NOTIFY THE APPLICABLE AGENCIES FOR ANY PERMITS, ORDINANCES, OR NON-COMPLIANCE OF SUCH CODES OR ORDINANCES BY THE CONTRACTOR DOCUMENTS UNDER MANAGEMENT OF CONSTRUCTION.


THE ARCHITECT'S RECORD SHALL BE THE RESPONSIBILITY OF THE CONTRACTOR FOR THE CONSTRUCTION OF THE PROJECT. THE ARCHITECT'S RECORD SHALL BE THE RESPONSIBILITY OF THE CONTRACTOR. THE ARCHITECT'S RECORD SHALL BE THE RESPONSIBILITY OF THE CONTRACTOR. THE ARCHITECT'S RECORD SHALL BE THE RESPONSIBILITY OF THE CONTRACTOR.

THESE CONSTRUCTION DOCUMENTS SHALL BE THE PROPERTY OF JACK GILLILAND ARCHITECT AND ARE NOT TO BE REPRODUCED OR COPIED IN ANY FORM OR MANNER WITHOUT THE WRITTEN CONSENT OF JACK GILLILAND ARCHITECT.

JACK GILLILAND ARCHITECT
AR 0009984

ALICO COMMERCE CENTER
BUILDING B

JAMES F. KNOTT REALTY GROUP
ONE TEXAS STATION COURT
TIMONIUM, MARYLAND

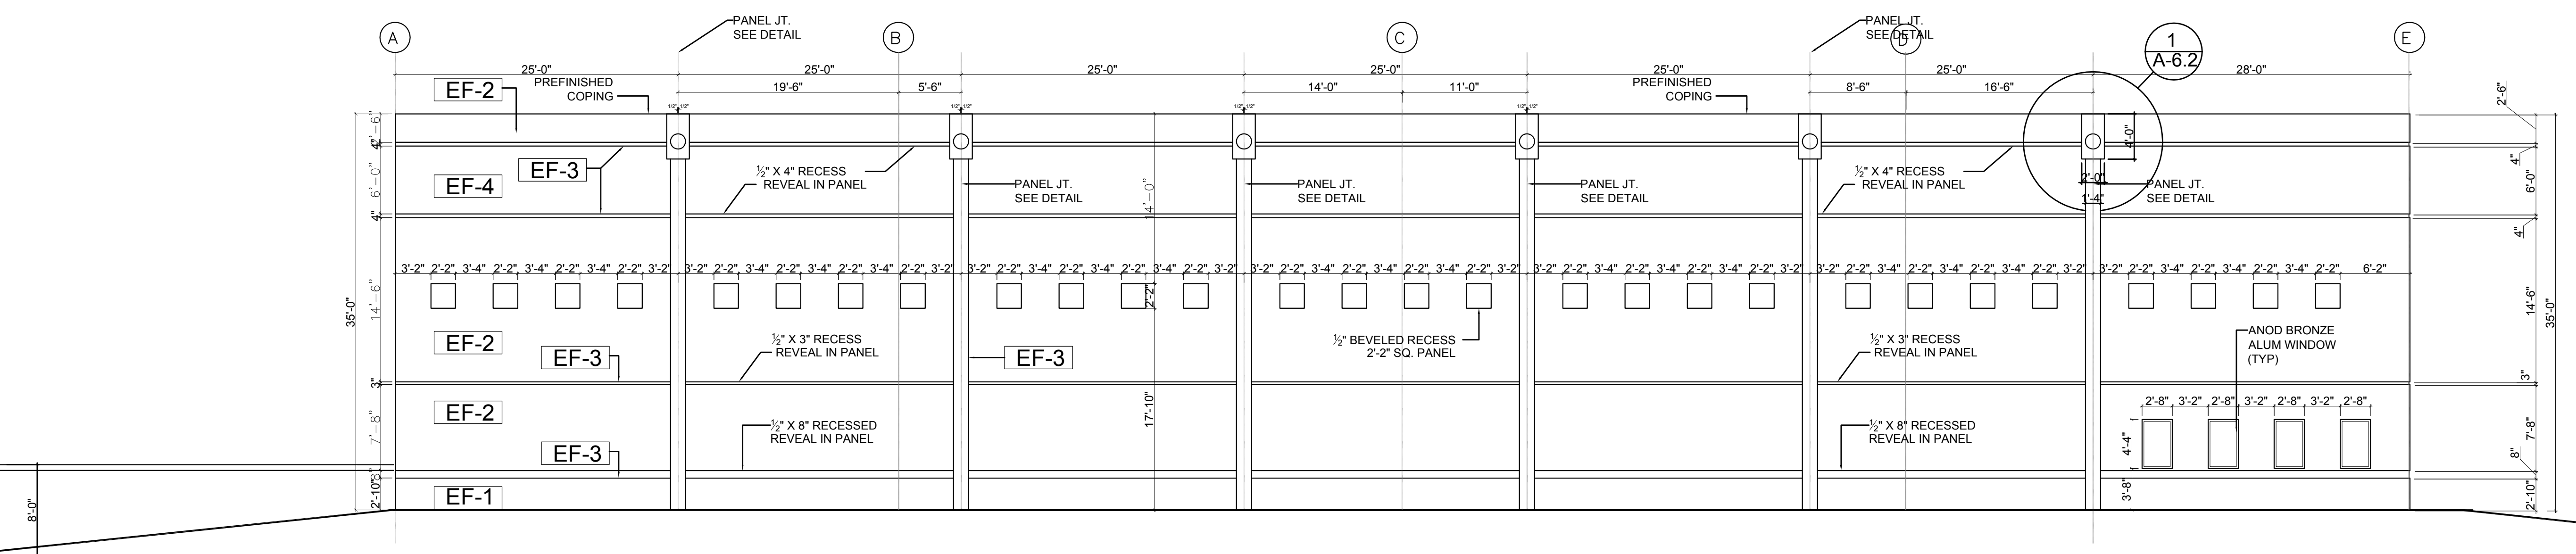

TYP SIDE OF BUILDING B

EXTERIOR FINISH SCHEDULE			
INDICATOR	PAINT MFG	COLOR	NUMBER
EF-1	SHERWIN WILLIAMS 100 SERIES		
EF-2	SHERWIN WILLIAMS 100 SERIES		
EF-3	SHERWIN WILLIAMS 100 SERIES		
EF-4	SHERWIN WILLIAMS 100 SERIES		

PLAN CHECK
CORRECTIONS
PERMIT NO. -
DATE: 12/7/2004
PROJECT #: 00/
DRAWN BY: D.A.W.
CHECKED BY:
REVISIONS: